


# T.39S. R.20E. W.M.

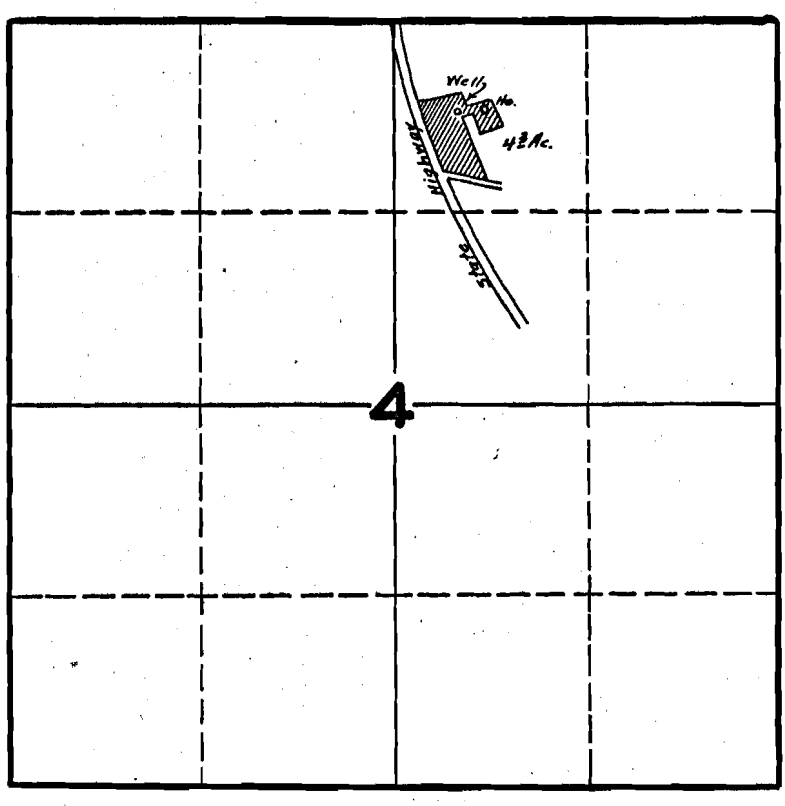

## FINAL PROOF SURVEY UNDER

Application No. U-152... Permit No. U-147

IN NAME OF

C. F. SNIDER

Surveyed MAY 24 1946, by [Signature]