


U-149
C-15547

T.6N.R.35E.W.M.

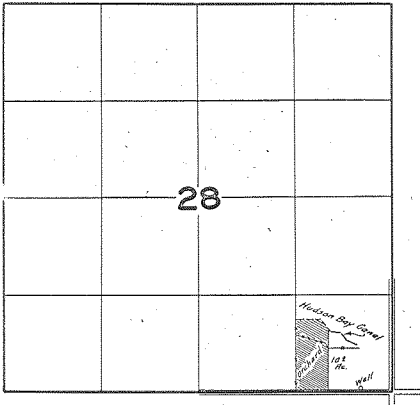

FINAL PROOF SURVEY UNDER

Application No. U-156 Permit No. U-149

IN NAME OF

J.M. HANSON

Surveyed APR. 19 1946, by 