


T.5N.R.35E.W.M.

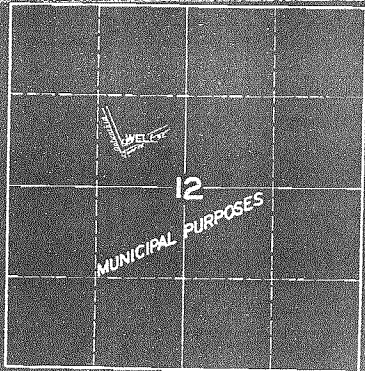

FINAL PROOF SURVEY

UNBER

Application No. U-159 Permit No. U-150

IN NAME OF

MILTON CITY - A MUNICIPAL CORPORATION

APR. 18 1946



C-15548