


T.5N.R.35E.W.M.

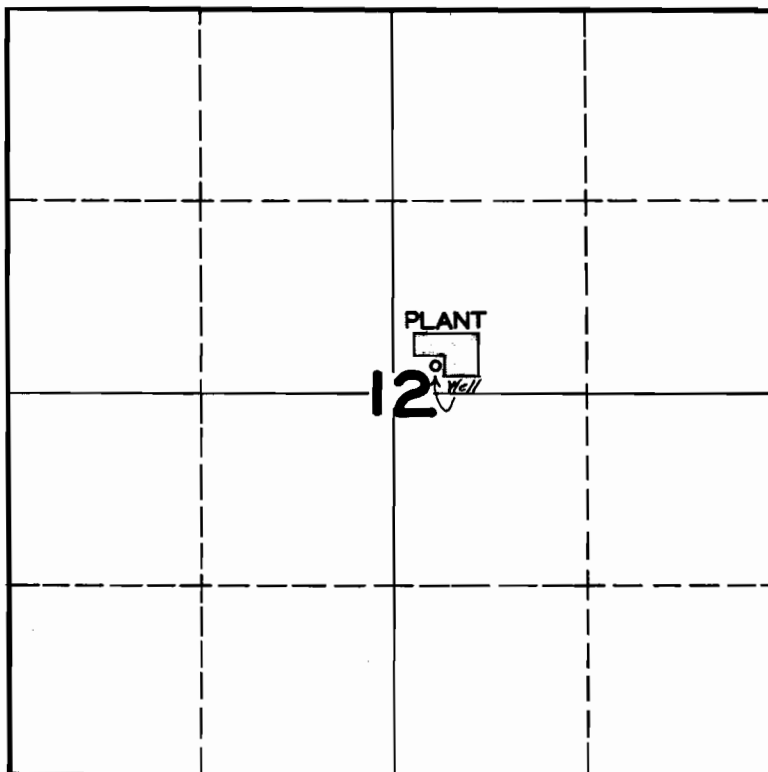

**FINAL PROOF SURVEY
UNDER**

Application No. U-157 Permit No. U-151

IN NAME OF

ROGERS CANNING COMPANY

Surveyed APR. 18 1946, by