


# T.15S. R.16E.W.M.

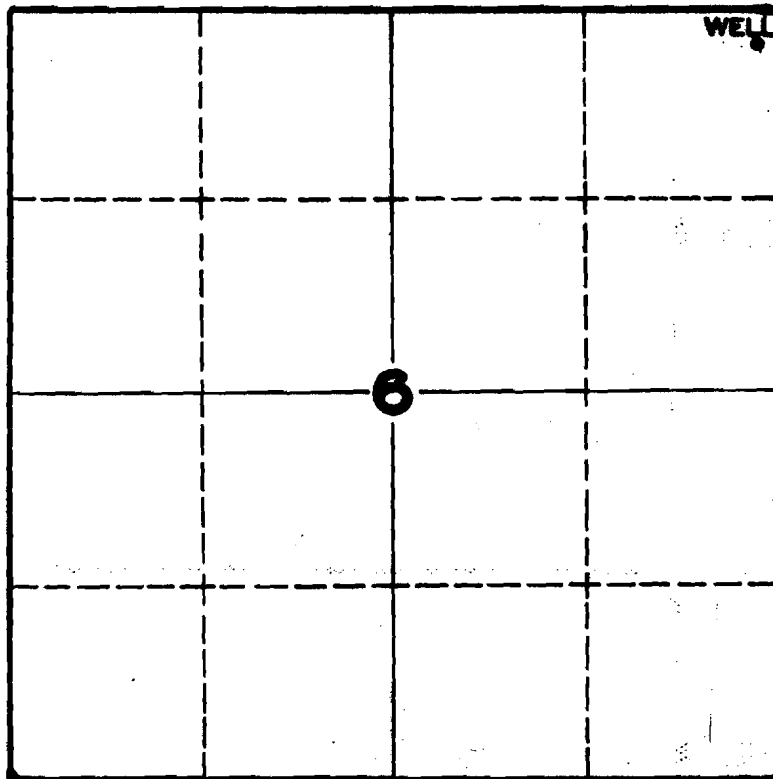

## FINAL PROOF SURVEY UNDER

Application No. U-161 Permit No. U-154

IN NAME OF

**WILLIAM MACKAY-MARY MACKAY-HIS WIFE AND ALICE GREA.**

Surveyed APR. 30 1944 by *[Signature]*