


# T.5N.R.35E.W.M.

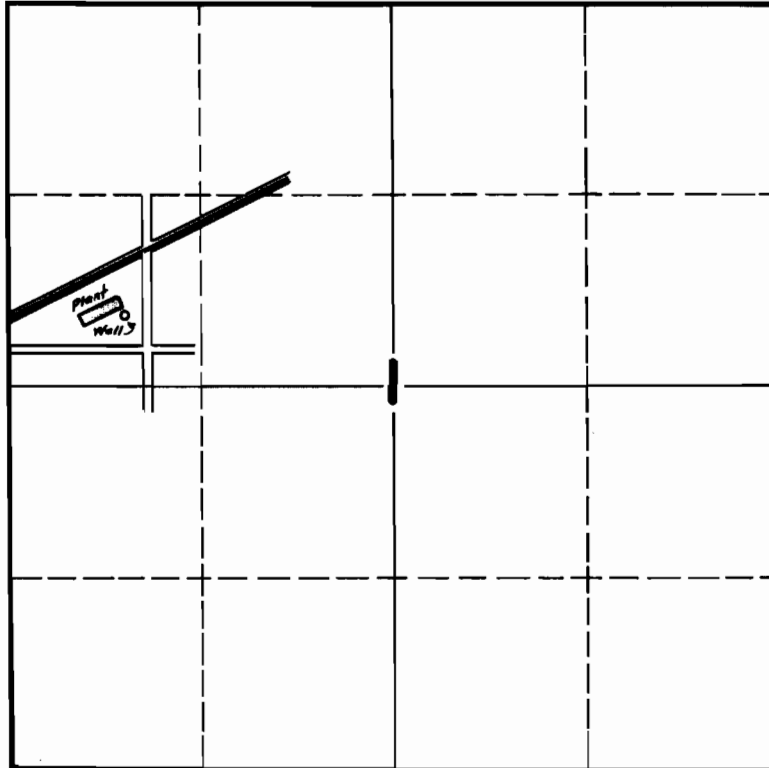

## FINAL PROOF SURVEY

UNDER

Application No. U-165 Permit No. U-158

IN NAME OF

UTAH CANNING CO

Surveyed APR. 18 1946, by