


T.6N.R.35E.W.M.

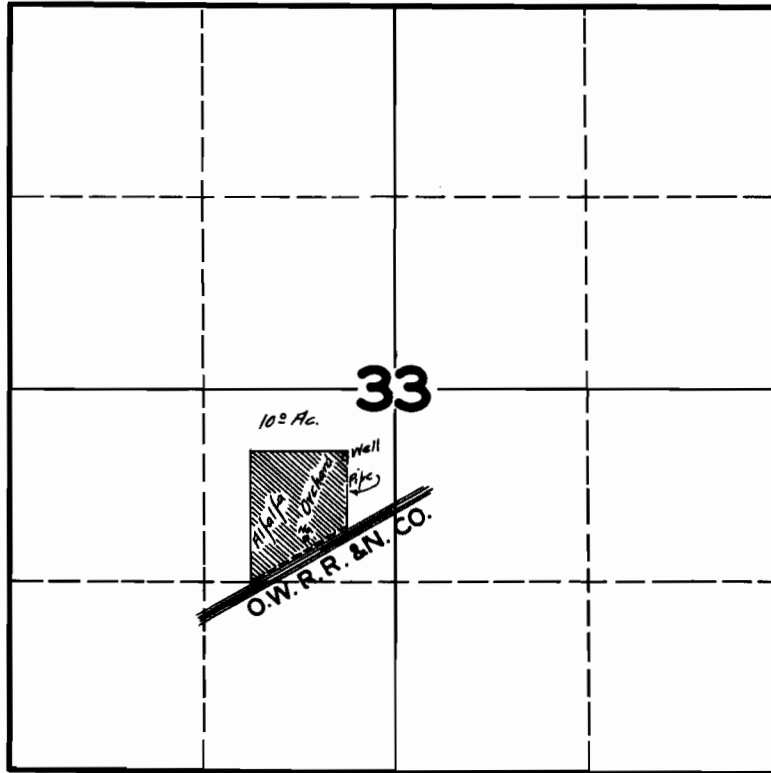

FINAL PROOF SURVEY UNDER

Application No. U-171 Permit No. U-164

IN NAME OF

J. T. WHARTON

Surveyed APR. 19 1946. by [Signature]