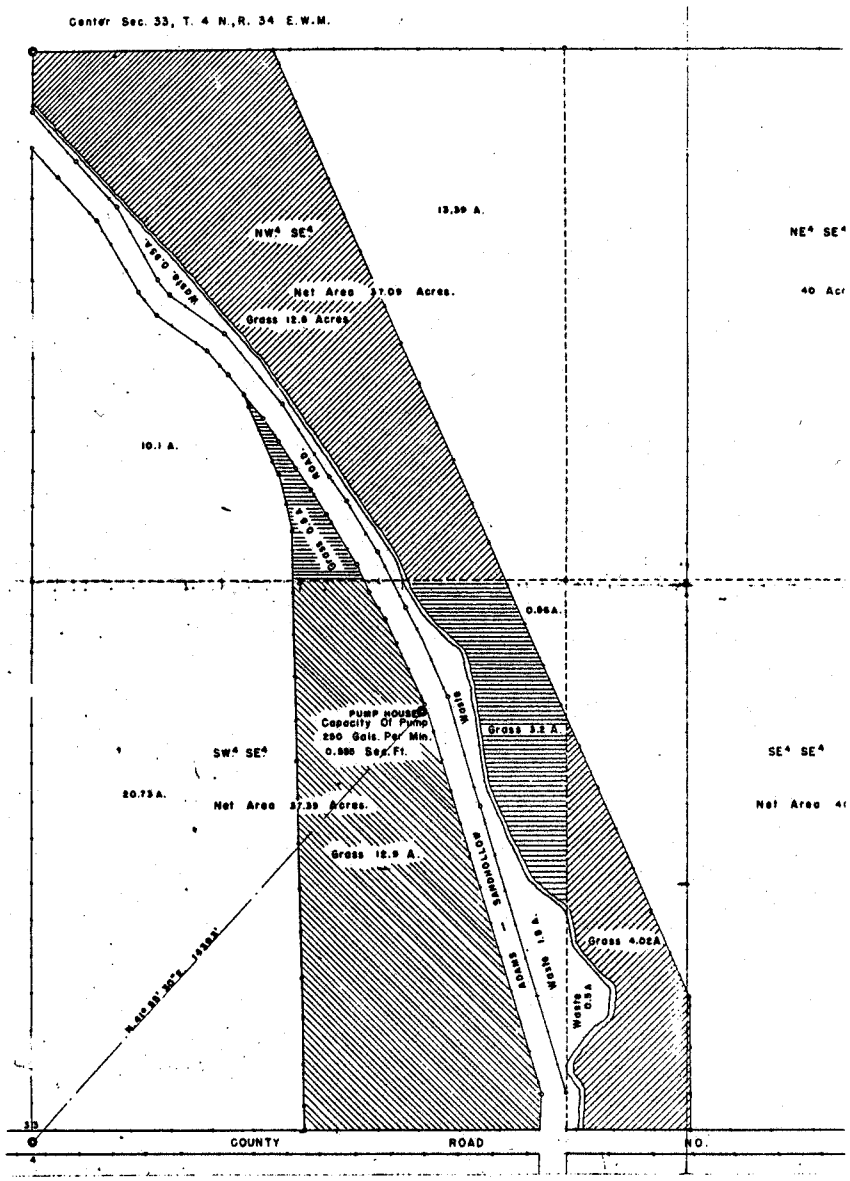

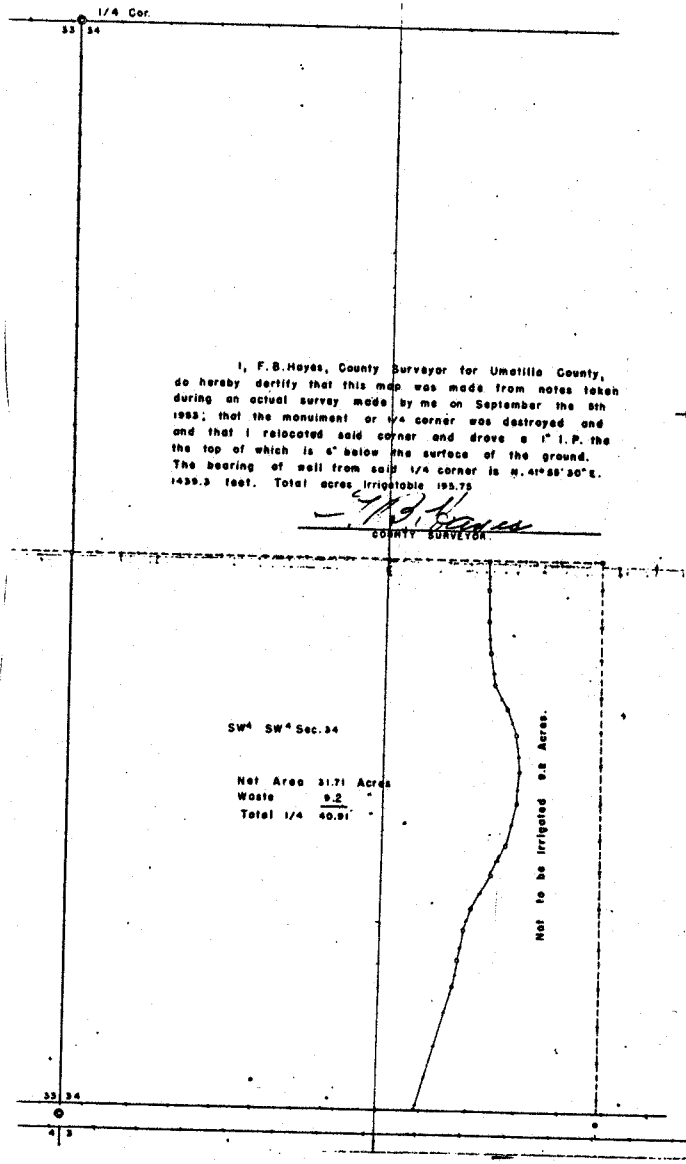

I, F. B. Hayes, County Surveyor for Umatilla County, do hereby certify that this map was made from notes taken during an actual survey made by me on September the 8th 1953; that the monument or 1/4 corner was destroyed and and that I relocated said corner and drove a 1" I.P. the the top of which is 6" below the surface of the ground. The bearing of well from said 1/4 corner is N. 41°28' 30" E. 1439.3 feet. Total acres irrigatable 195.75

F. B. Hayes
COUNTY SURVEYOR.

F. B. Hayes

PLAT OF SURVEY
FOR
L.L.ROGERS.
LOCATION OF DEEP WELL
AND LAND TO BE IRRIGATED.
LOCATED IN THE SE¼ OF SECTION 33
T. 4 N., R. 34 E.W.M.
Scale 1" = 200'

Application No. U-682-2979
Permit No. U-619

C-15554 U-169