


T.17S. R.4W.W.M.

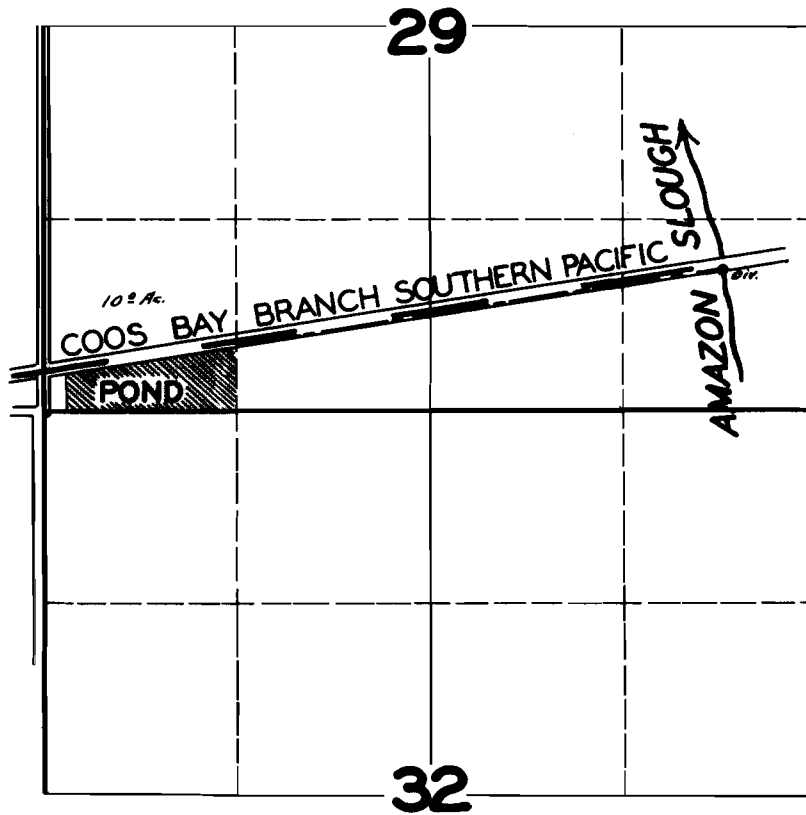

FINAL PROOF SURVEY

UNDER

Application No. R-20691 20692 Permit No. R-810 16186

IN NAME OF

SILVER FALLS TIMBER COMPANY

Surveyed JULY 30 1945, by [Signature]