


T.2S. R.10W.W.M.

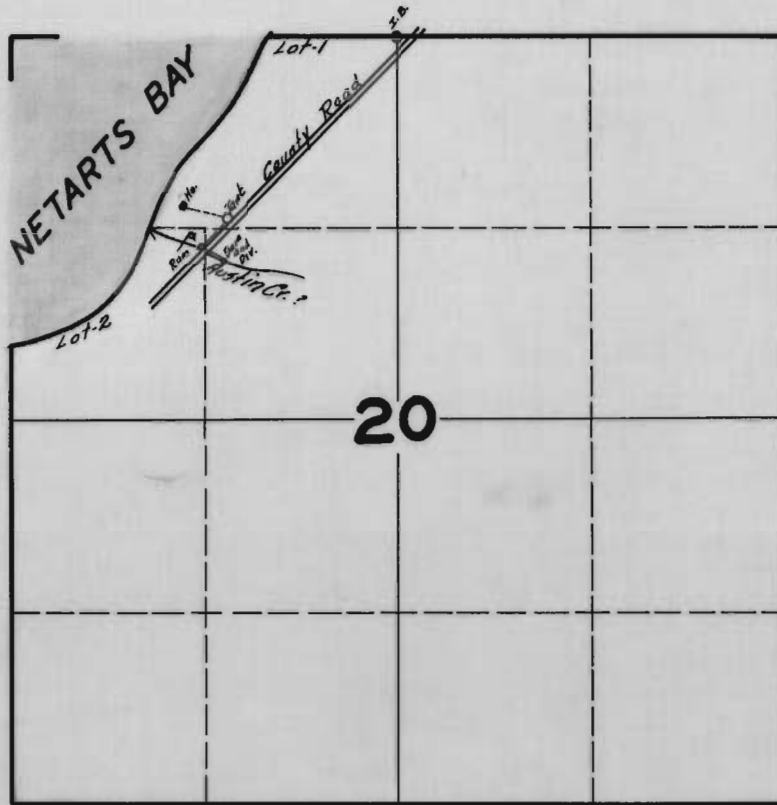

FINAL PROOF SURVEY

UNDER

Application No. 18674 Permit No. 14305

IN NAME OF

ALLEN P. KOFOLD

Surveyed JUNE 19 1945, by James D. Sumrell