


T.2 S. R. I. E. W. M.

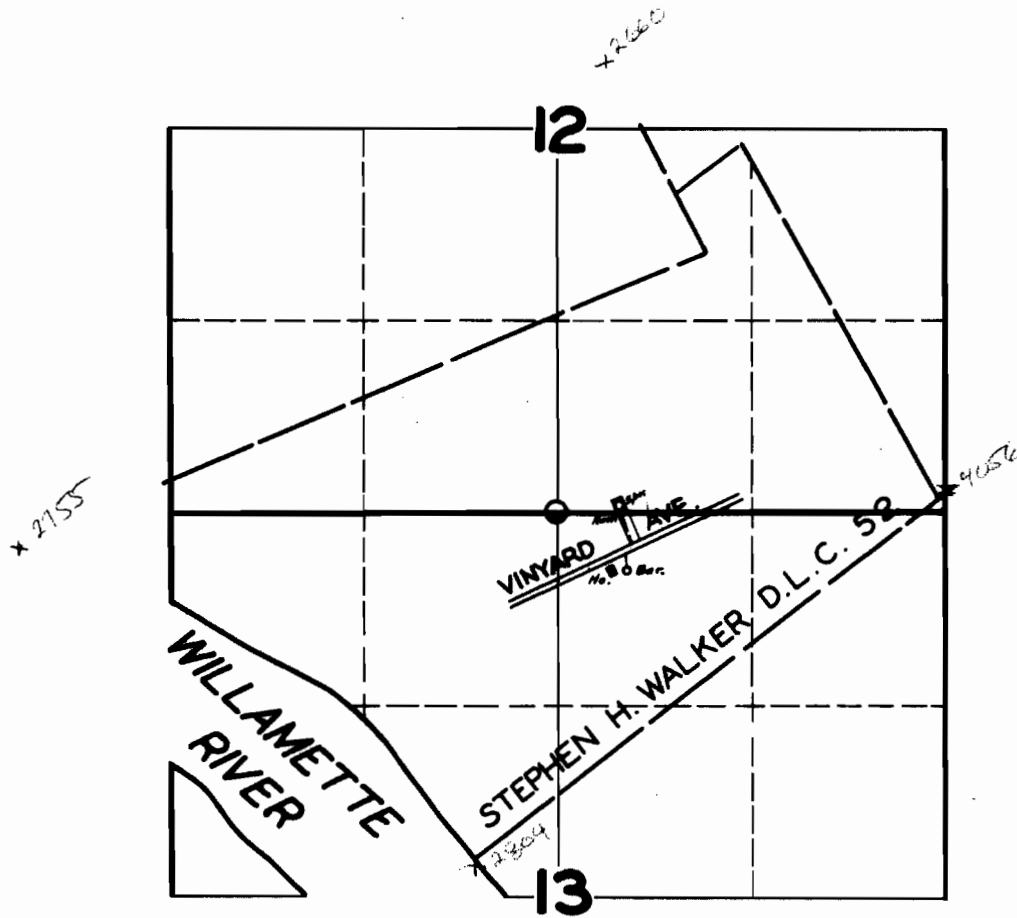

FINAL PROOF SURVEY UNDER

Application No. 20017 Permit No. 15588

IN NAME OF

CHARLES P. ANDREWS

Surveyed JULY 3, 1945 by