


**T.3S.R.2W.W.M.**

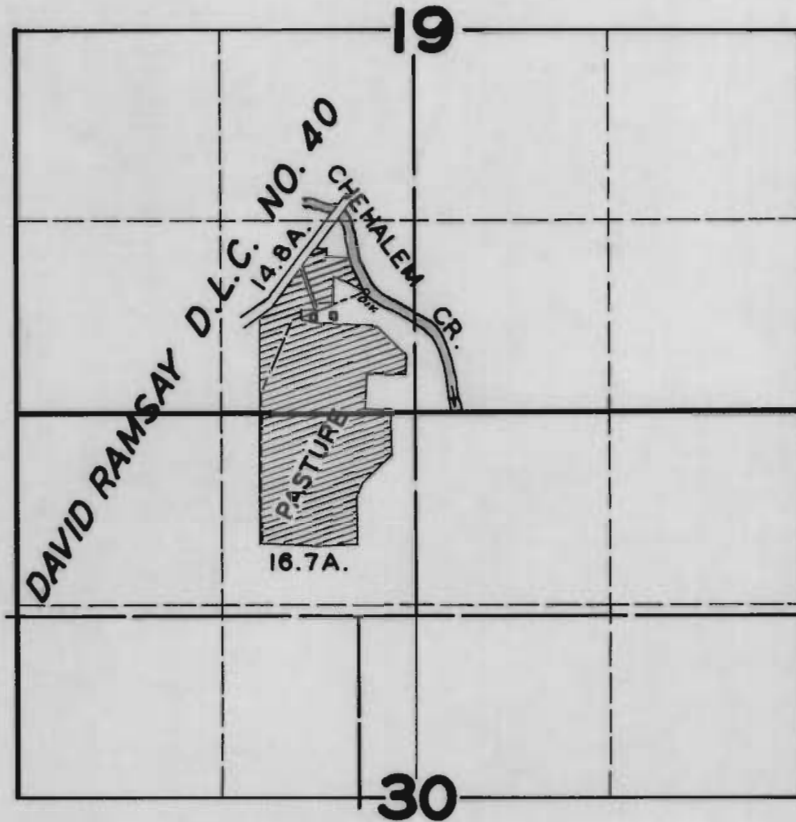

**FINAL PROOF SURVEY**

UNDER

Application No. 15722 Permit No. 11577

IN NAME OF

CLARENCE ASCHE

Surveyed MAR. 8 1946, by JAS. E. BUNNELL