


T.5S.R.3E.W.M.

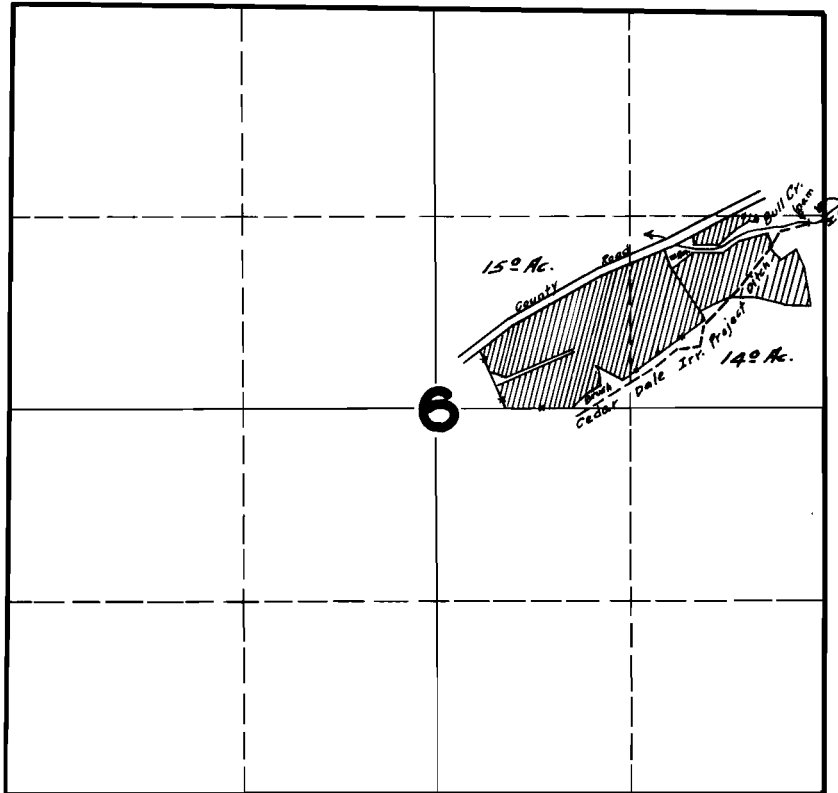

FINAL PROOF SURVEY UNDER

Application No. 15947 Permit No. 11786

IN NAME OF

WM. SCHMITZ

Surveyed SEPT. 7, 1945, by

[Handwritten Signature]