


T.7S.R.38E.W.M.

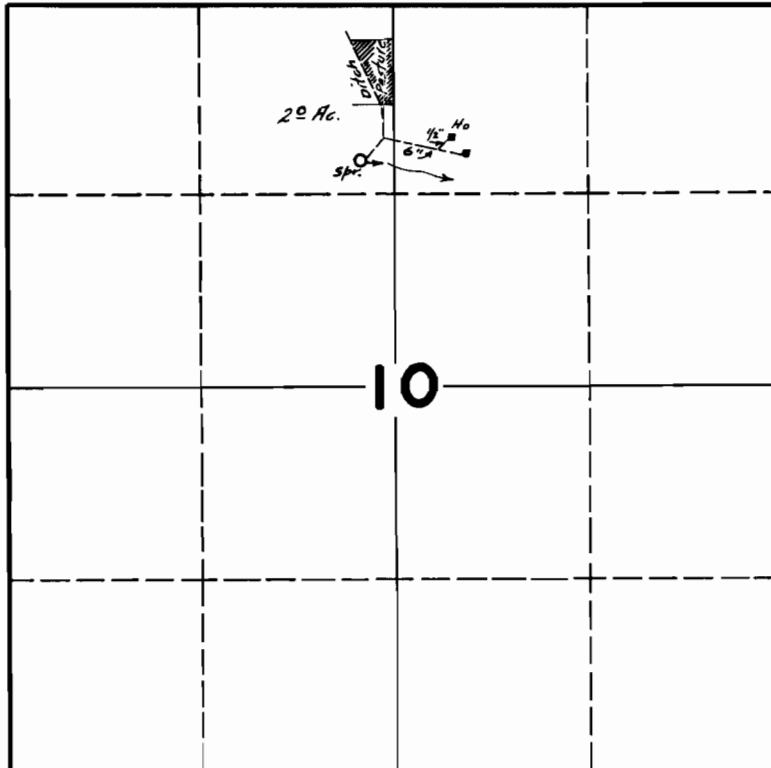

FINAL PROOF SURVEY UNDER

Application No. 15963 Permit No. 11796

IN NAME OF

LESTER H. BOND

Surveyed JULY 3 1946, by Paul E. Russell