


T. 7S. R. 1E. W.M.

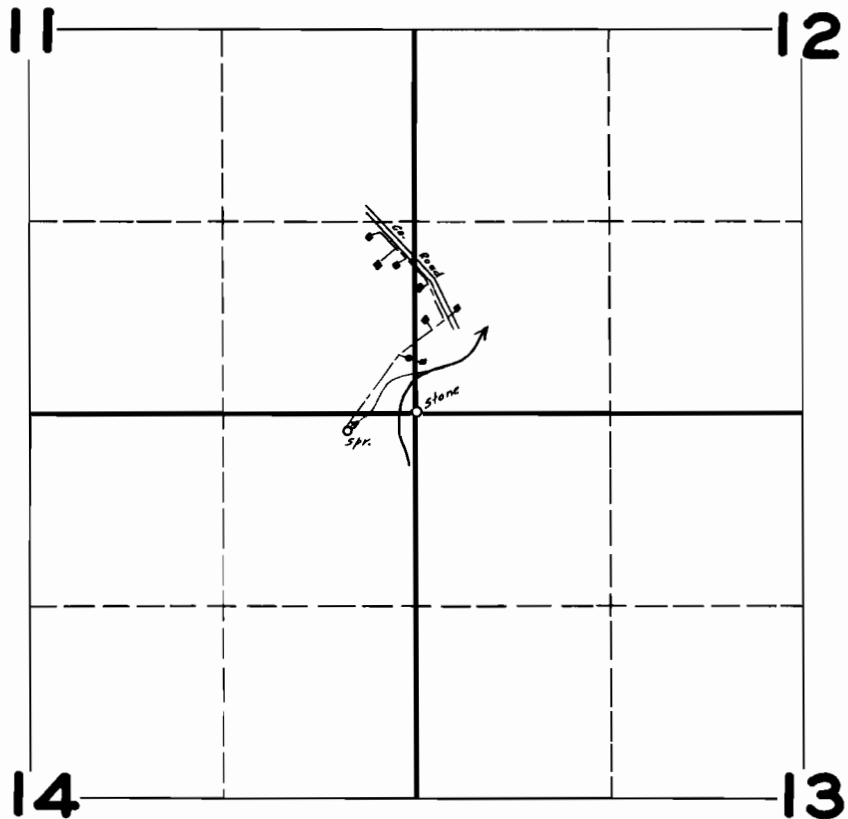

FINAL PROOF SURVEY
UNDER

Application No. 15955 Permit No. 11887

IN NAME OF

JESSE BARKHURST

Surveyed AUG. 30 1946, by [Signature]