


# T. 19 S. R. 3 W. W. M.

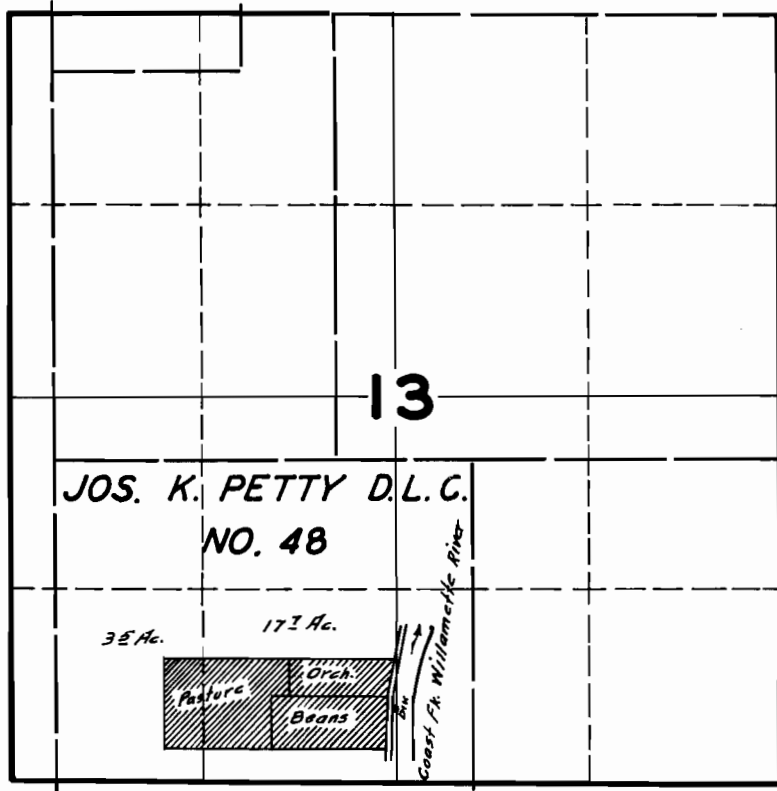

## FINAL PROOF SURVEY UNDER

Application No. 16145 Permit No. 11963

IN NAME OF

LELAND HEART

Surveyed JULY 23 1946, by

*[Signature]*