


# T. 2 S. R. 2 E. W. M.

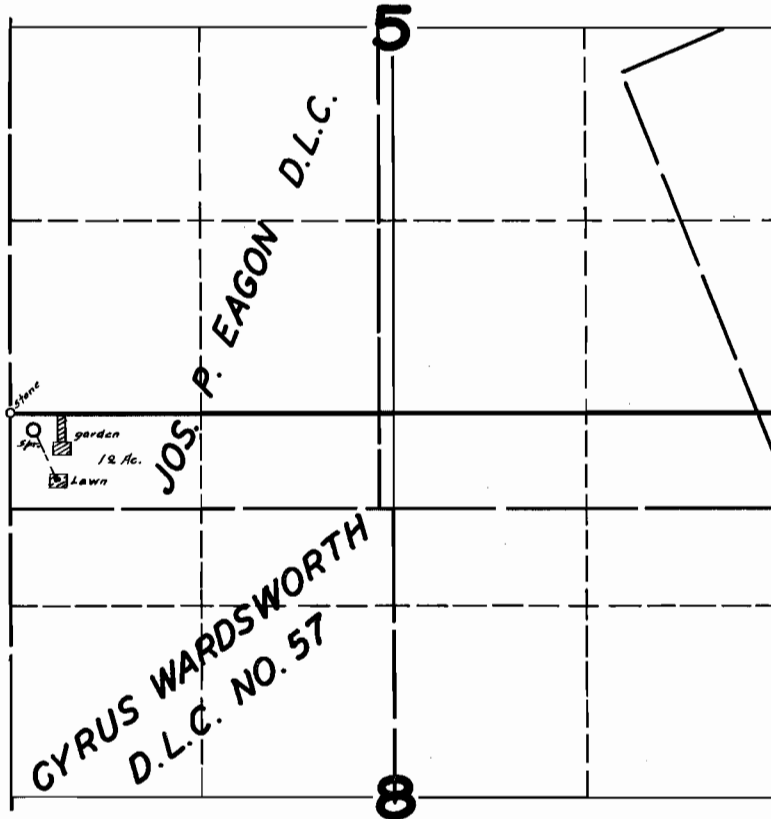

## FINAL PROOF SURVEY

UNDER

Application No. 16604 Permit No. 12471

IN NAME OF

LAURA & GEORGE E. BINGHAM

Surveyed JUNE 11 1946, by [Signature]