


T. 2S. R. 31E. W. M.

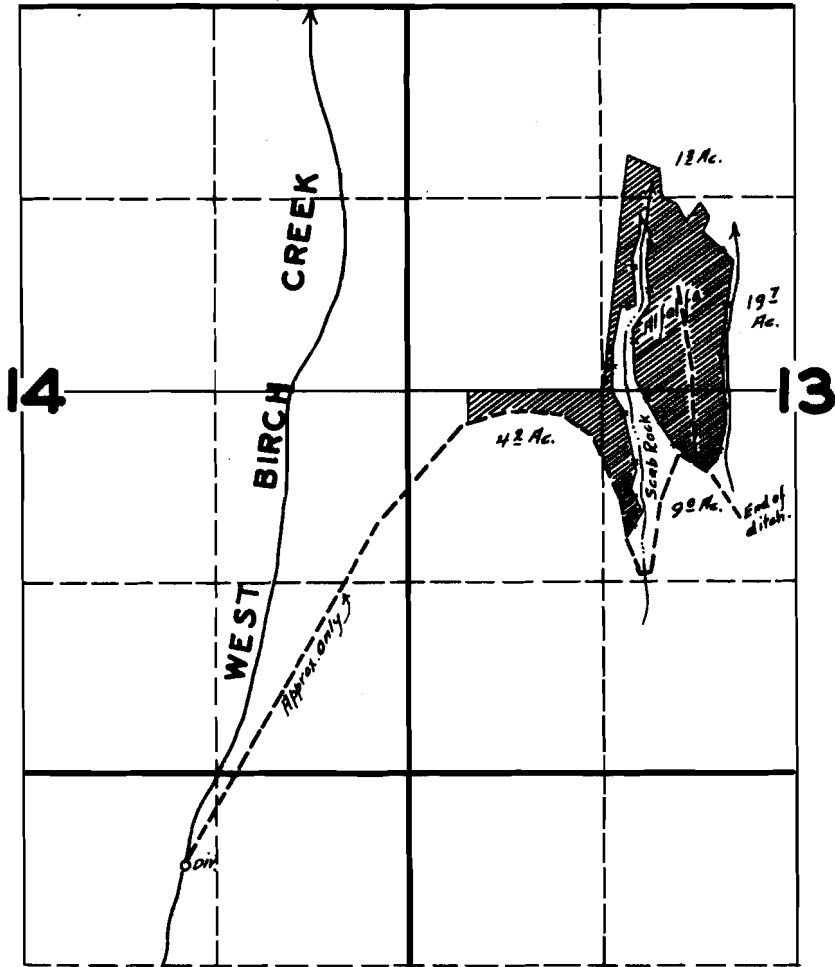

**FINAL PROOF SURVEY
UNDER**

Application No. 16786 Permit No. 12562

**IN NAME OF
LEE F. TEMPLE.**

Surveyed APR. 22 1946, by JAS. E. BUNNELL