


T. 2S. R. 33E. W. M.

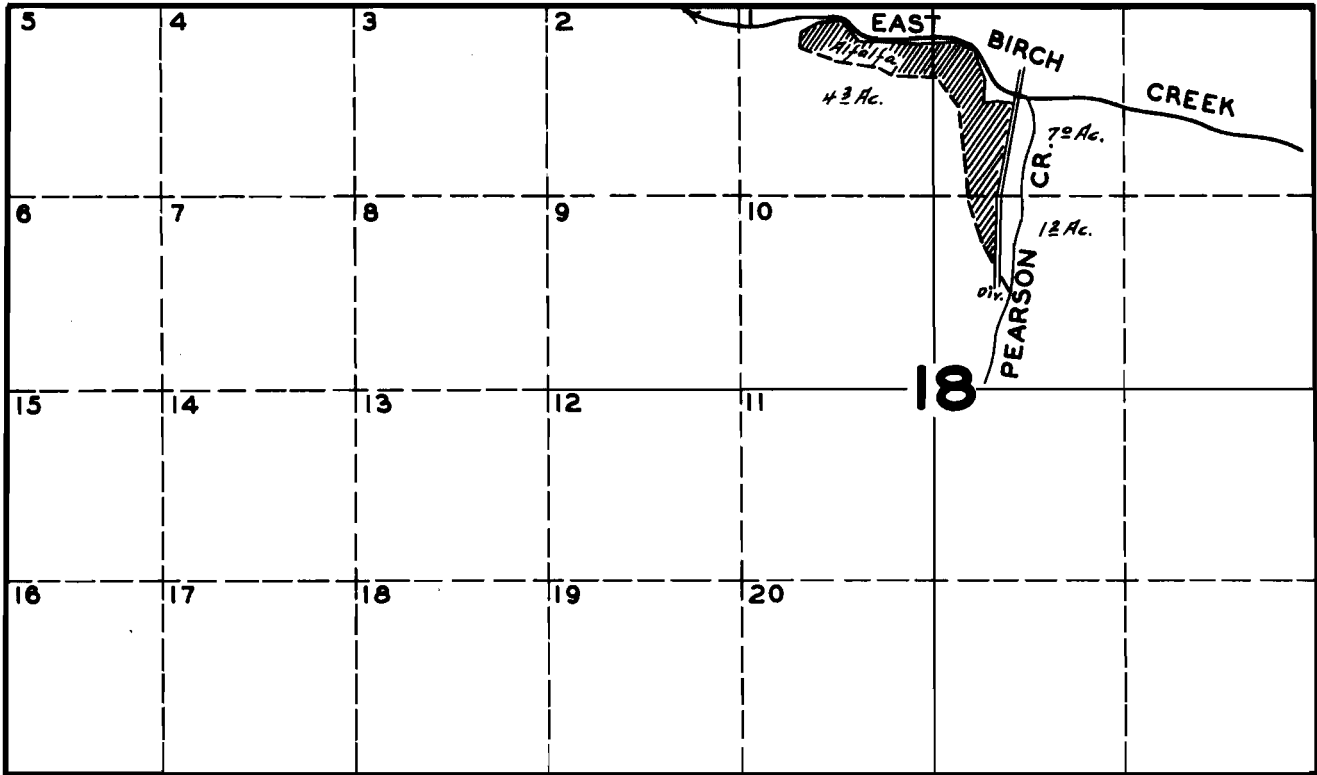

FINAL PROOF SURVEY UNDER

Application No. 16903 Permit No. 12663

IN NAME OF

J. ARVINE PORTER

Surveyed APR. 22 1946, by JAS. E. BUNNELL