


T.16S.R.47 & 48E.W.M.

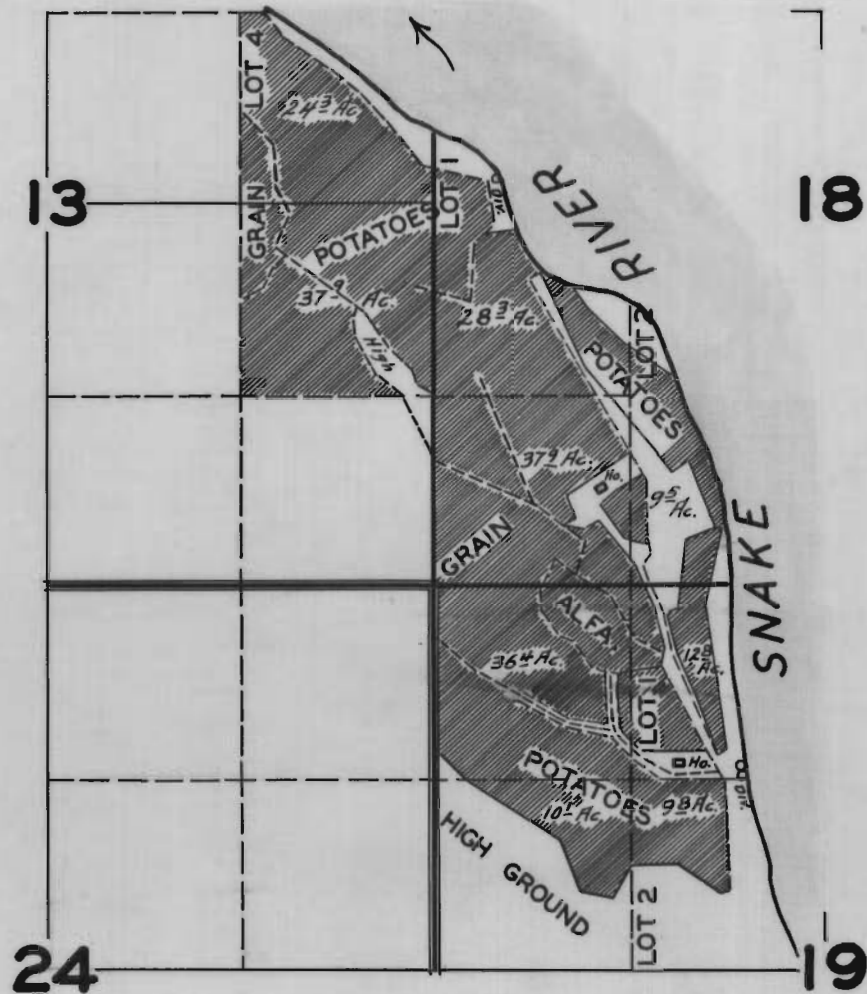

FINAL PROOF SURVEY

UNDER

Application No. 17017 Permit No. 12763

IN NAME OF

HELEN ARLENE LEWIS

Surveyed JUNE 5 1946, by