


T.3S.R.41E.W.M.

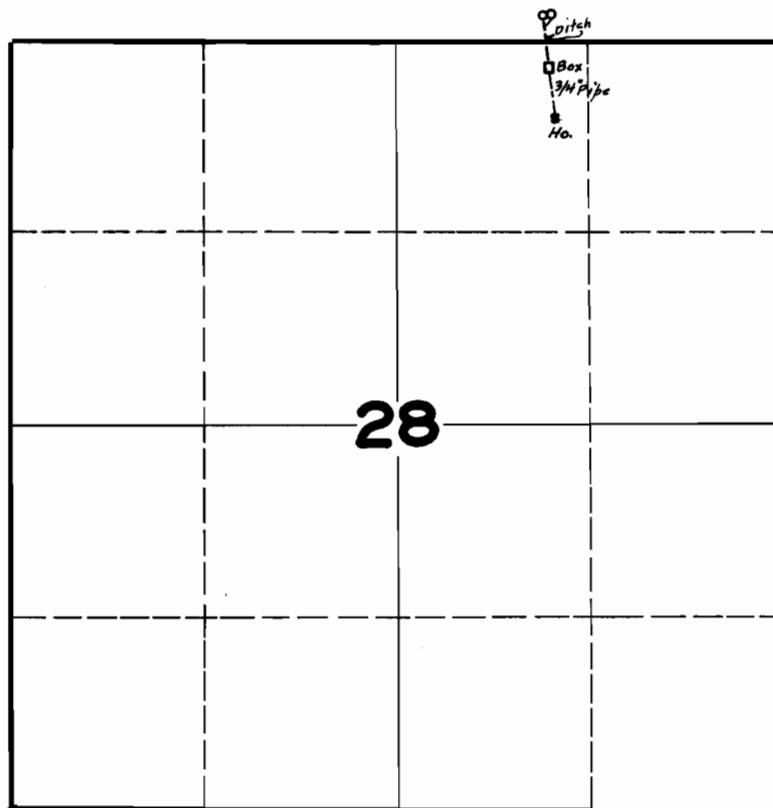

**FINAL PROOF SURVEY
UNDER**

Application No. 17915 Permit No. 13601

IN NAME OF

WHITMAN NATIONAL FOREST

Surveyed JULY 1 1946, by JAS. E. BUNNELL