


# T. 15. R. 2 W. W. M.

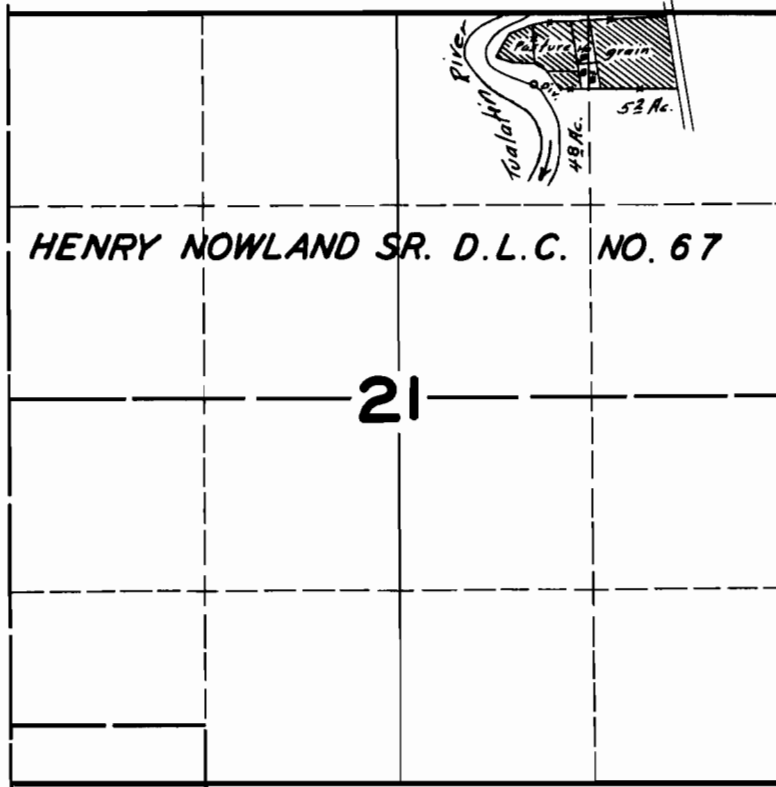

## FINAL PROOF SURVEY UNDER

Application No. 17930 Permit No. 13613

IN NAME OF

A. E. CAMPBELL

Surveyed AUG. 19 1946, by [Signature]