


T. 16 S., R. 7 W. W.M.

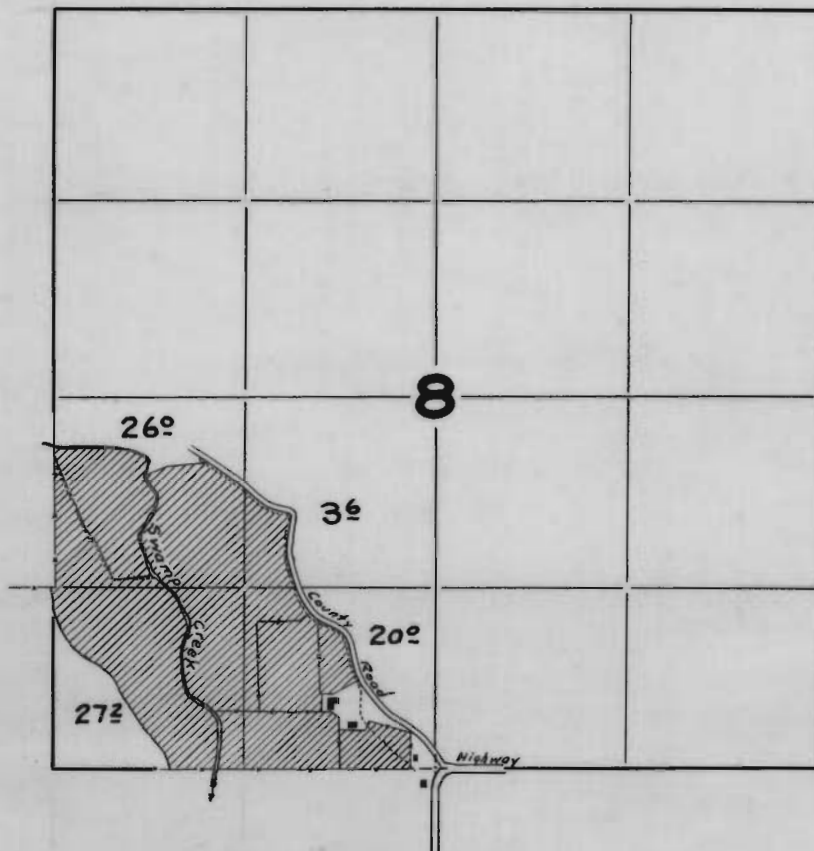

**FINAL PROOF SURVEY
UNDER**

Application No. 17933 Permit No. 13616

IN NAME OF

W. B. Blachly

Surveyed Aug. 9 1943, by Geo. J. Adelman