


# T. 1 N. R. 3 W. W. M.

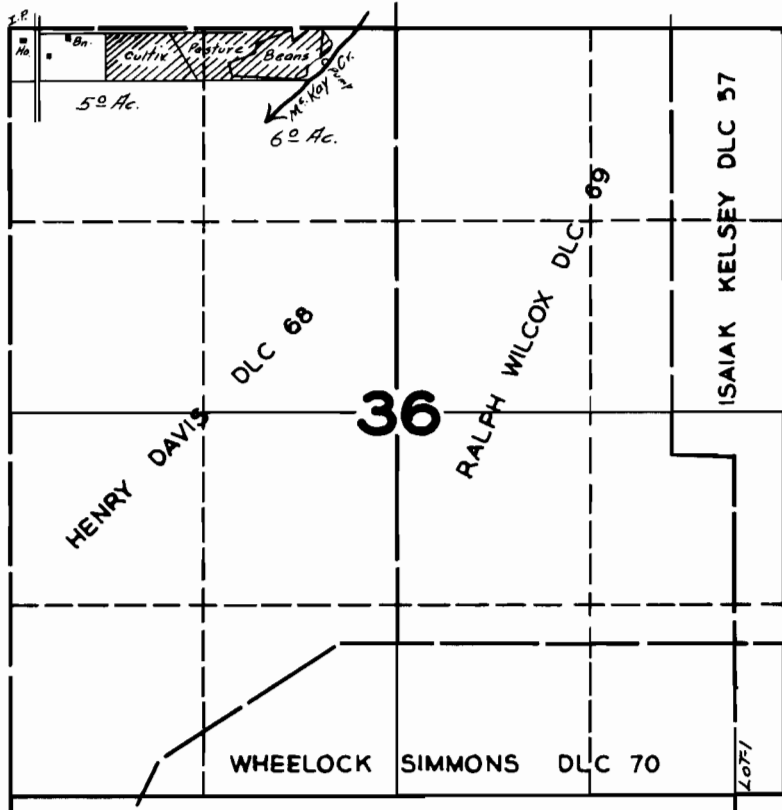

## FINAL PROOF SURVEY UNDER

Application No. 18014    Perm. No. 13686

GEO. E. & ADA L. PADGETT

Surveyed JULY 17 1944, by *James Russell*