


T.2 S. R.1 W.W.M.

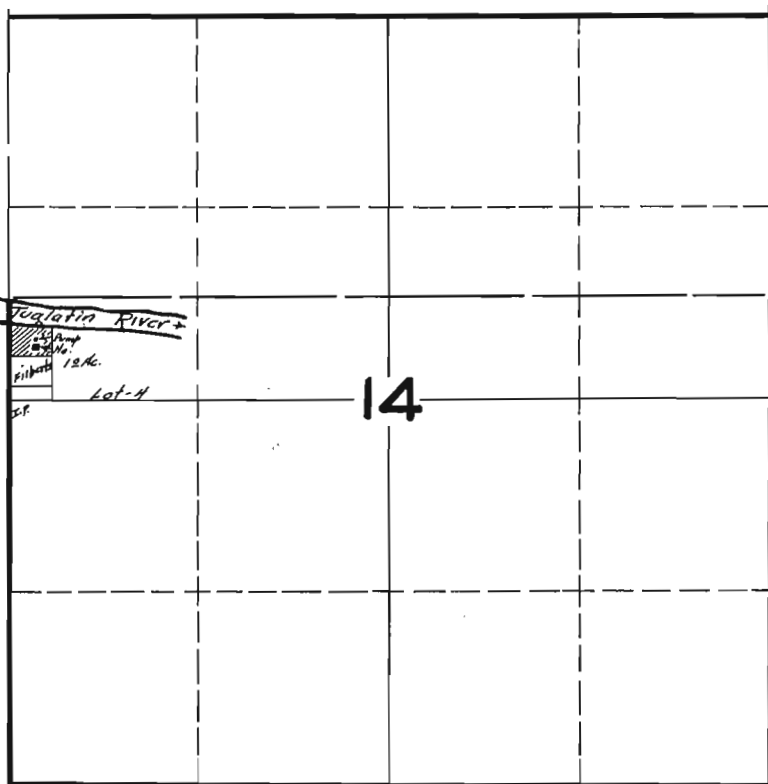

FINAL PROOF SURVEY
UNDER

Application No. 18095 Permit No. 13755

IN NAME OF

VIOLA ORTSCHILD

Surveyed AUG. 28 1945 by [Signature]