


T.18S.R.47E.W.M.

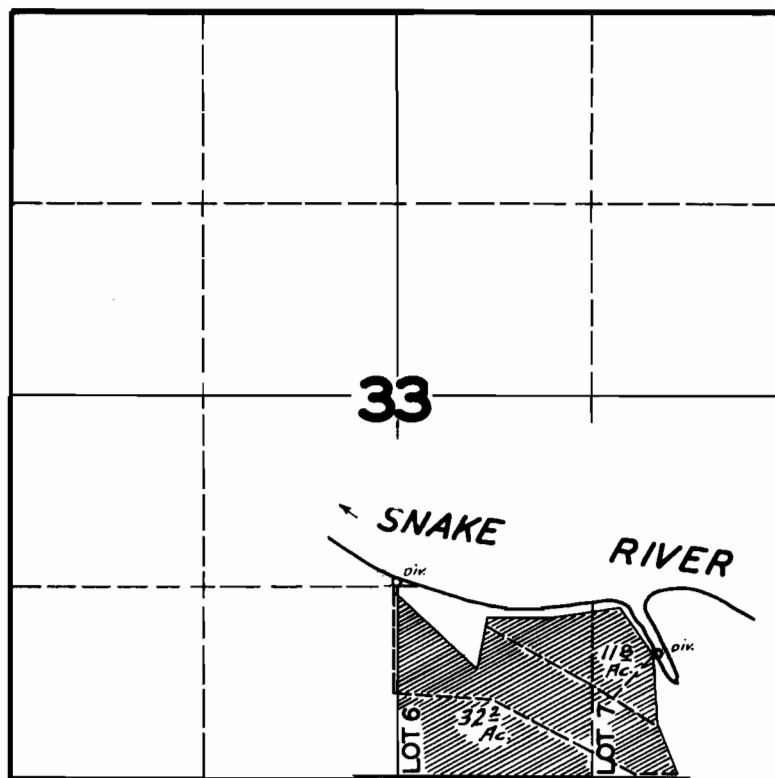

FINAL PROOF SURVEY
UNDER

Application No. 18225 Permit No. 13887

IN NAME OF
ANGUS H. BISHOP

Surveyed MAY 28 1946, by Robert S. Russell