


T.3S.R.32E.W.M.

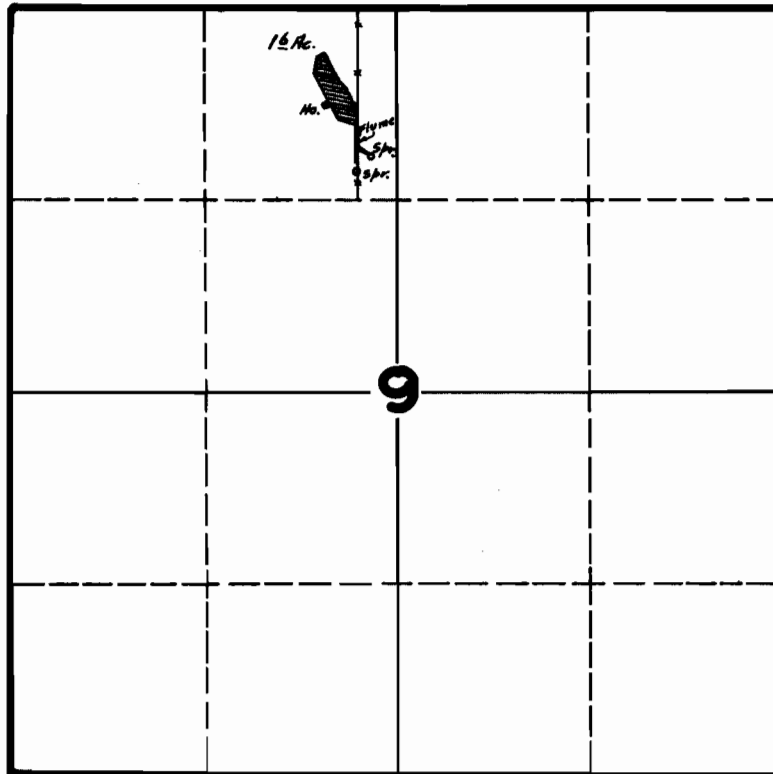

FINAL PROOF SURVEY
UNDER

Application No. 18254 Permit No. 13910

IN NAME OF

R.E. MERKLING

Surveyed APR. 22 1946, by JAS. E. BUNNELL