


T.4 S. R3 W. W.M.

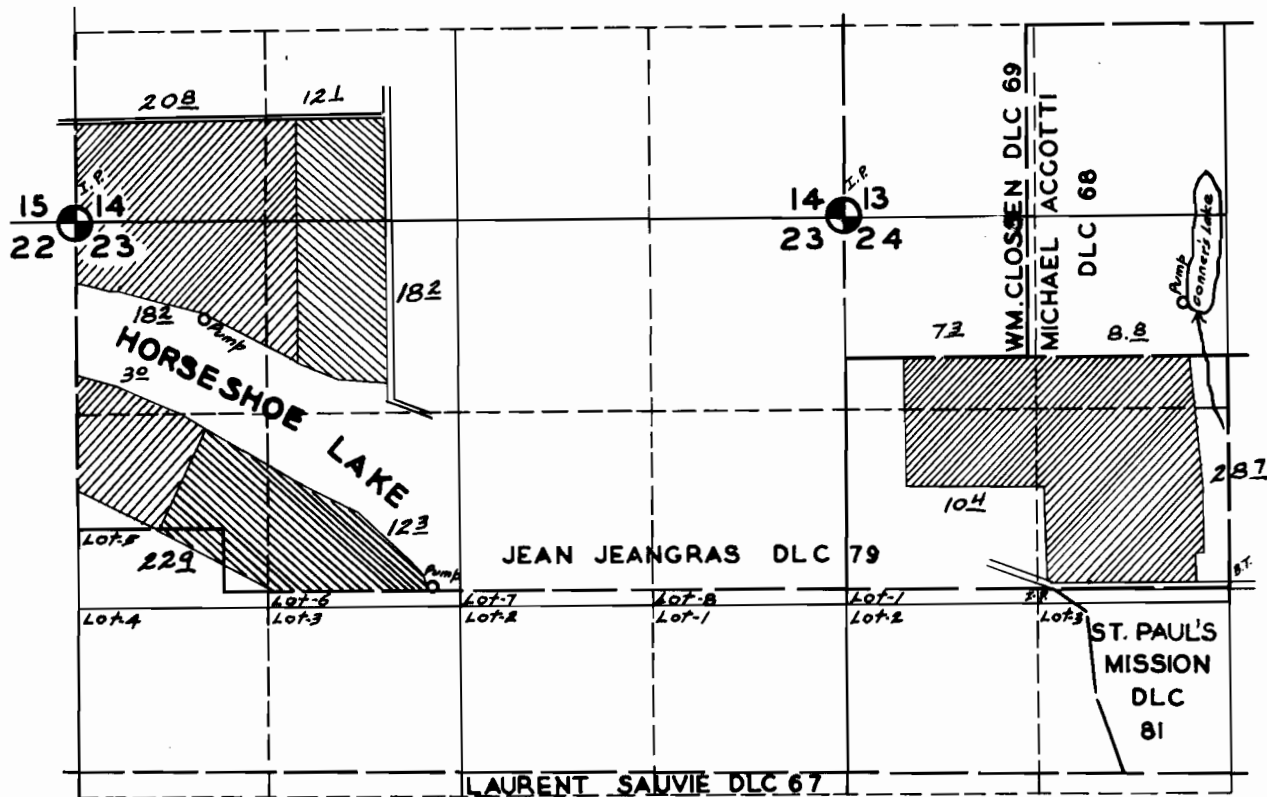

FINAL PROOF SURVEY

UNDER

Application No. 18280 Permit No. 13929

IN NAME OF

C.R. & B.T. BRENTANO

Surveyed JUNE 21 1944, by *J. P. Bremer*