T.9S. R.6W.W.M.

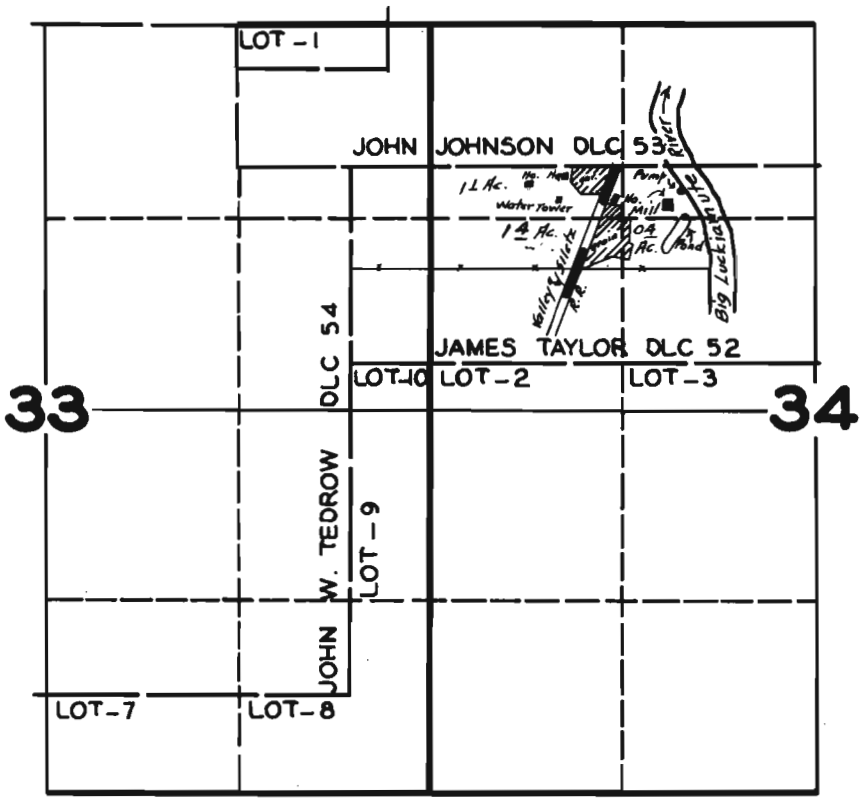

FINAL PROOF SURVEY

UNDER

Application No. 18299 Permit No. 13945

IN NAME OF

VAN DEN BOSCH LUMBER CO.

Surveyed AUG. 18 1944, By [illegible]

1944 - E