


T.9S. R. 2E.W.M.

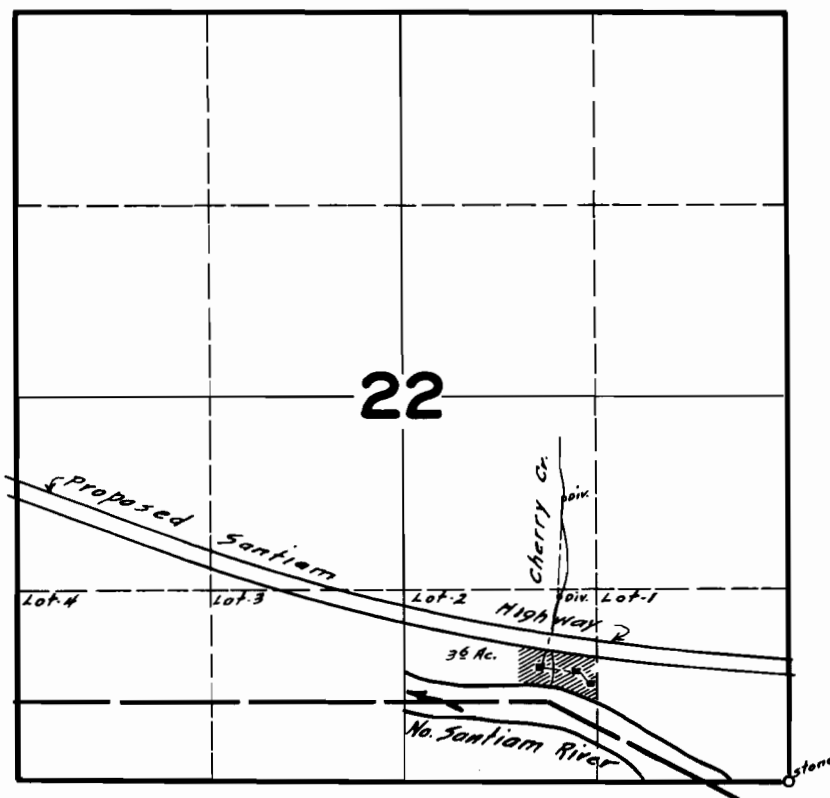

FINAL PROOF SURVEY UNDER

Application No. 18310 Permit No. 13951

IN NAME OF

O. K. & ELLEN T. DE WITT

Surveyed APR. 6, 1946, by [Signature]