


SECTION

TOWNSHIP 15 S, RANGE 13 E, W. M.

C-15588

North

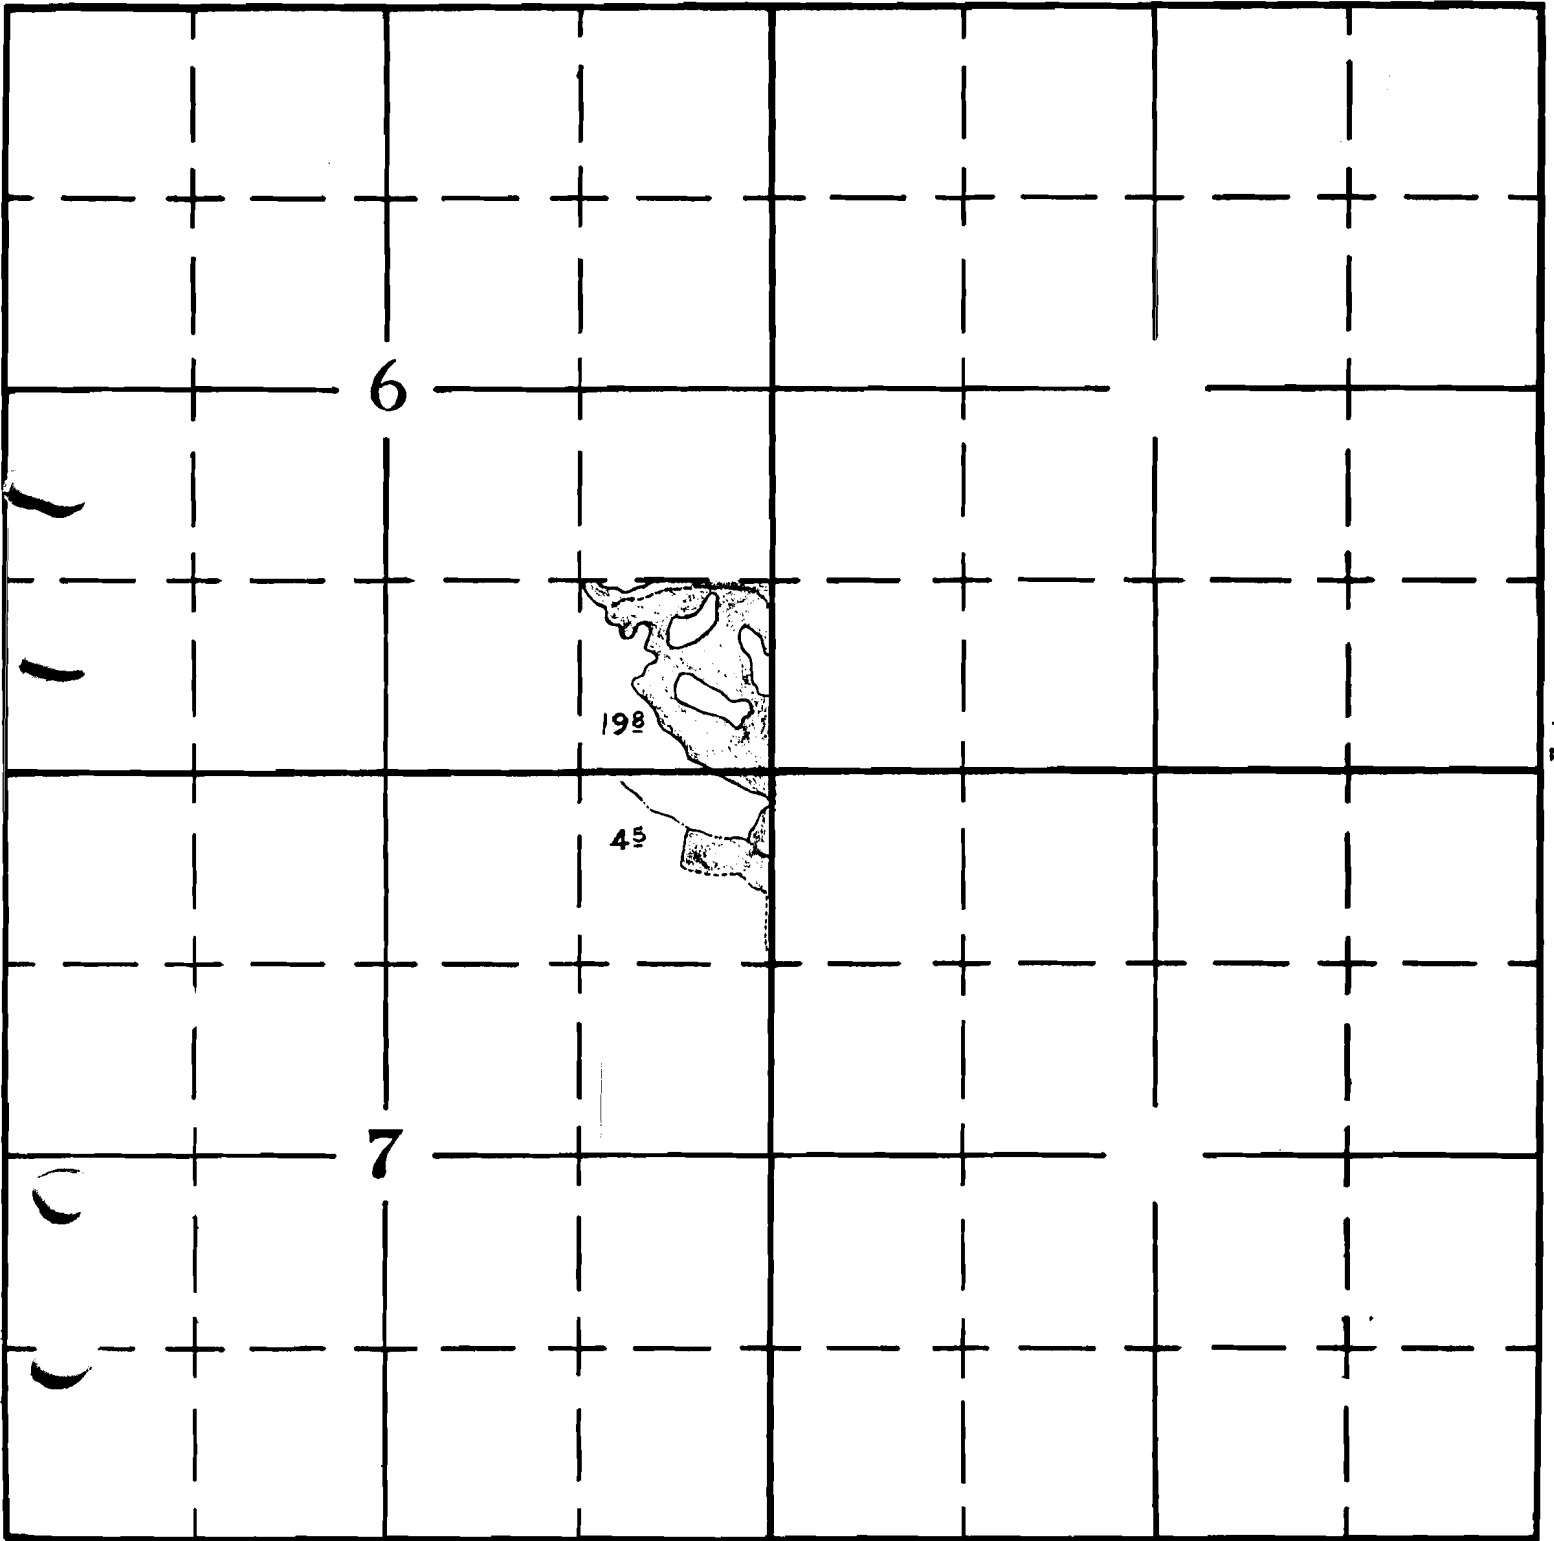

South

APPLICATION No. 18542

PERMIT No. 14108

15

14108