


T.2S.R.3W.W.M.

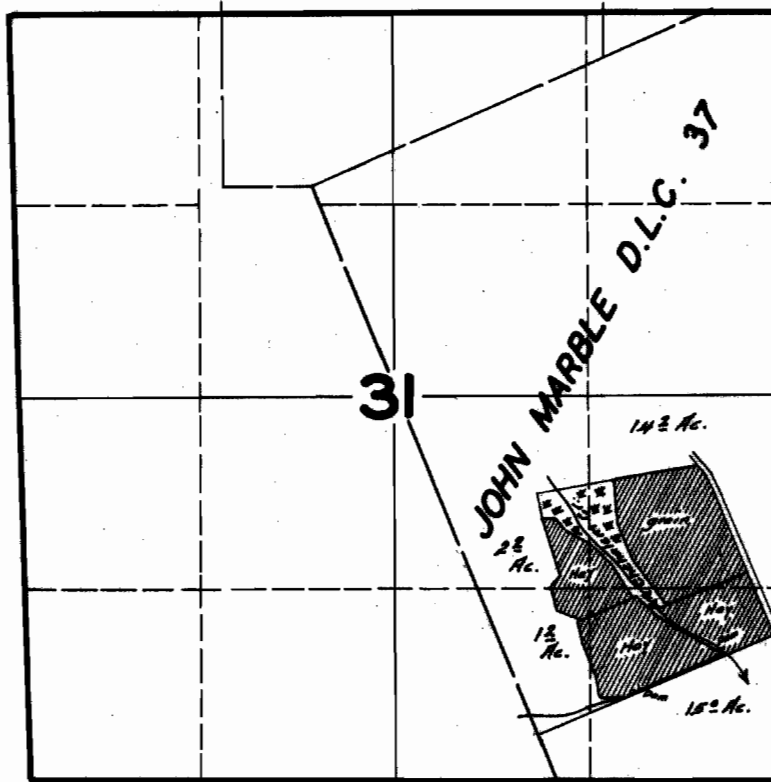

**FINAL PROOF SURVEY
UNDER**

Application No. 18491 Permit No. 14157

IN NAME OF

OLIVER J. COLES

Surveyed JUNE 13 1945