


T.2S.R.4E.W.M.

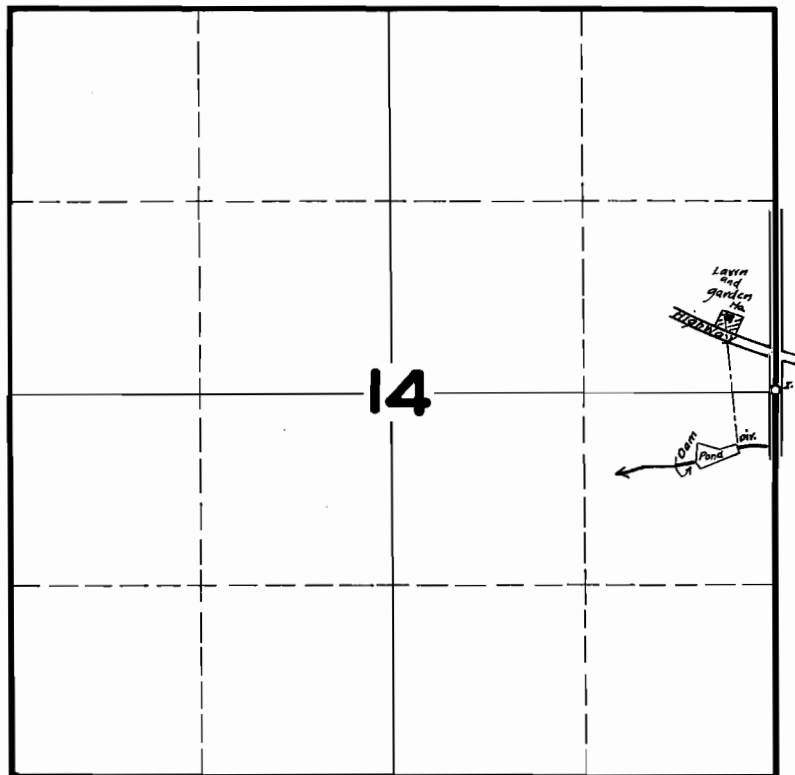

**FINAL PROOF SURVEY
UNDER**

Application No. 18566 Permit No. 14219

IN NAME OF

ED. F. BRUNS

Surveyed SEP. 13 1946, by

[Signature]