


**T.6S. R.10W.W.M.**

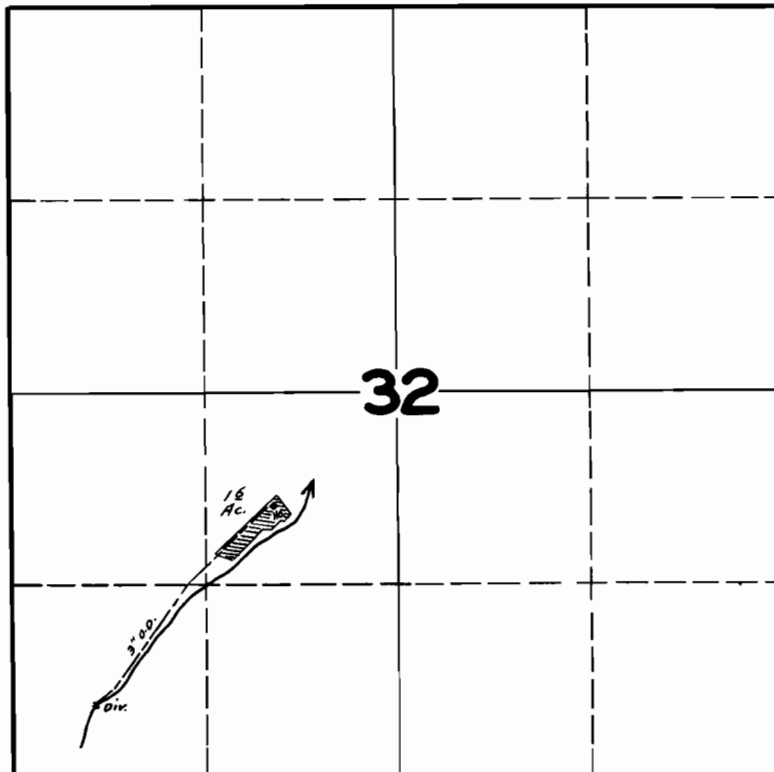

**FINAL PROOF SURVEY  
UNDER**

Application No. 18525 Permit No. 14396

IN NAME OF

JAMES C. & MABEL MORRIS

Surveyed JULY 5, 1945 by James C. Russell