


# T.6 S. R. 1 E. W. M.

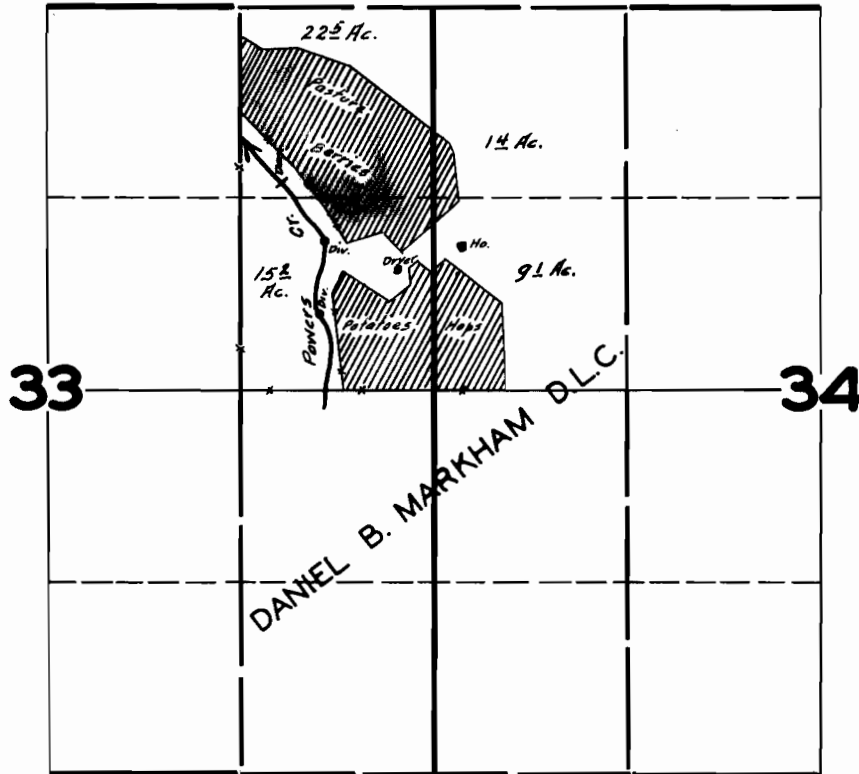

## FINAL PROOF SURVEY

UNDER

18923

14533

Application No. 20290 Permit No. 15828

IN NAME OF

FRANK PICKENS & PEARL PICKENS

Surveyed SEPT. 29 1945, by

*James D. Sumrell*