


T. 6 S. R. 1 W. W. M.

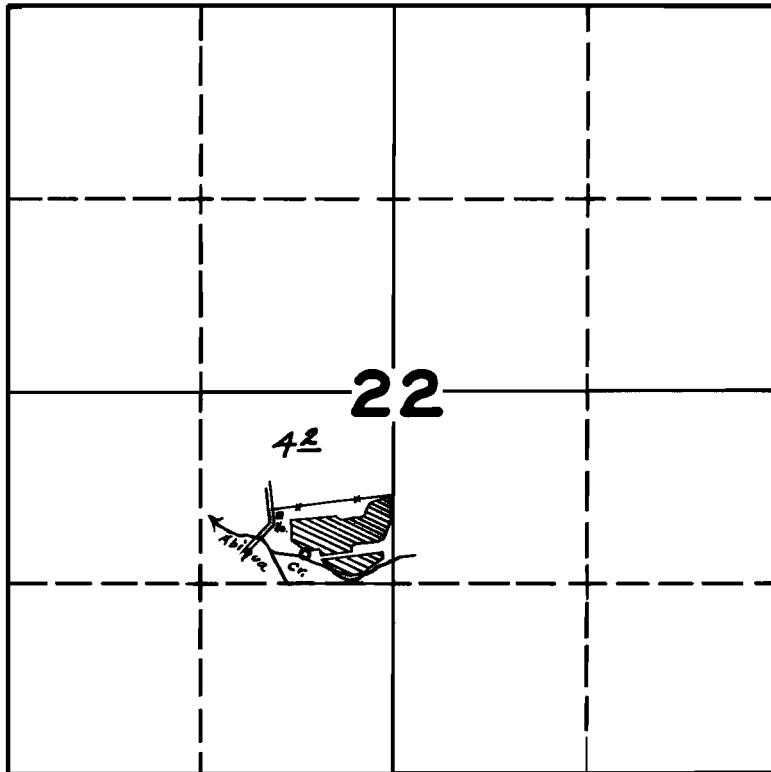

FINAL PROOF SURVEY

UNDER

Application No. 192 48 Permit No. 14829

IN NAME OF

A. S. LAMBERT

Surveyed JUNE 22 1944, by

A handwritten signature in cursive script, appearing to read 'James B. Runnel', written over a horizontal line.