


# T.4S. R.4W.W.M.

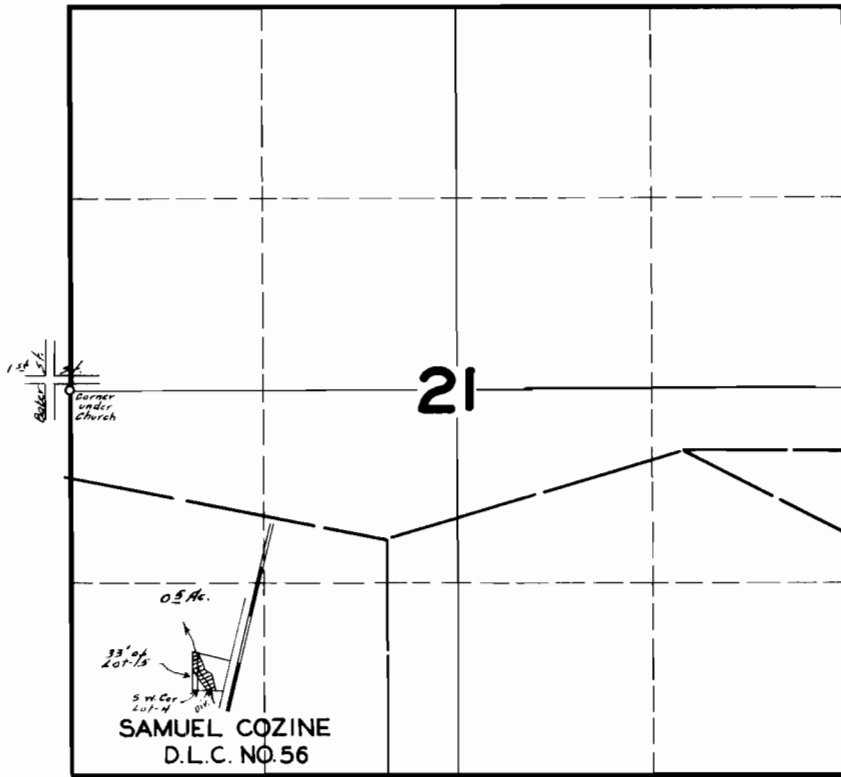

## FINAL PROOF SURVEY UNDER

Application No. 19279 Permit No. 14872

IN NAME OF

STANLEY TAYLOR

Surveyed MAR. 8 1946, by