


T.17S. R.12W.W.M.

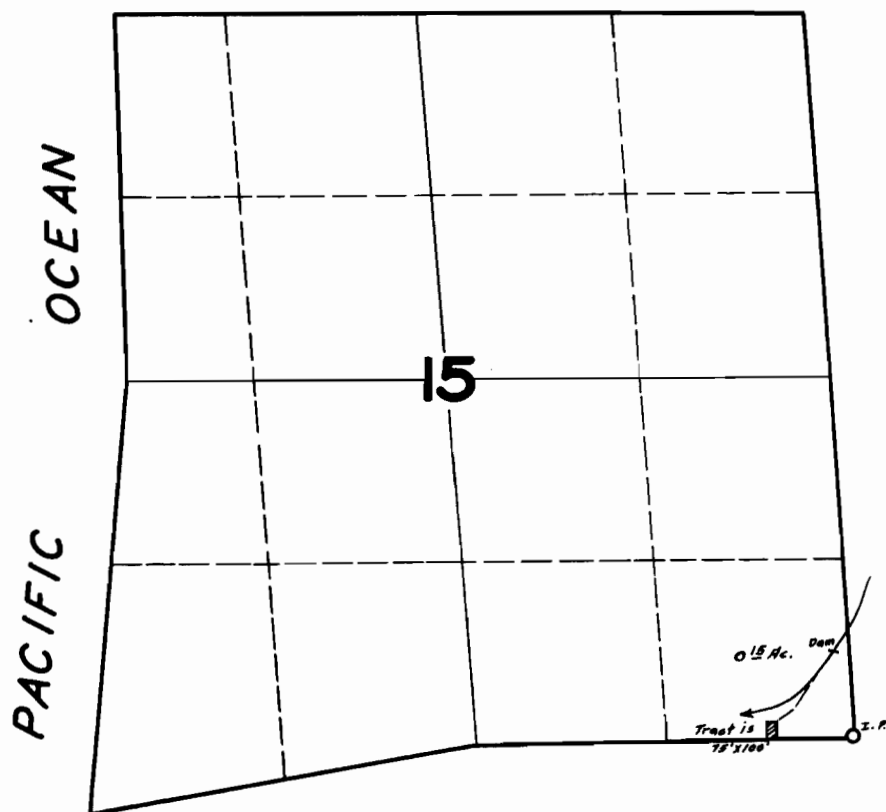

FINAL PROOF SURVEY
UNDER

Application No. 19382 Permit No. 15010

IN NAME OF

D.M. KYLE

Surveyed AUG. 7, 1945, by *[Signature]*