


T. 1 S. R. 10 W. W. M.

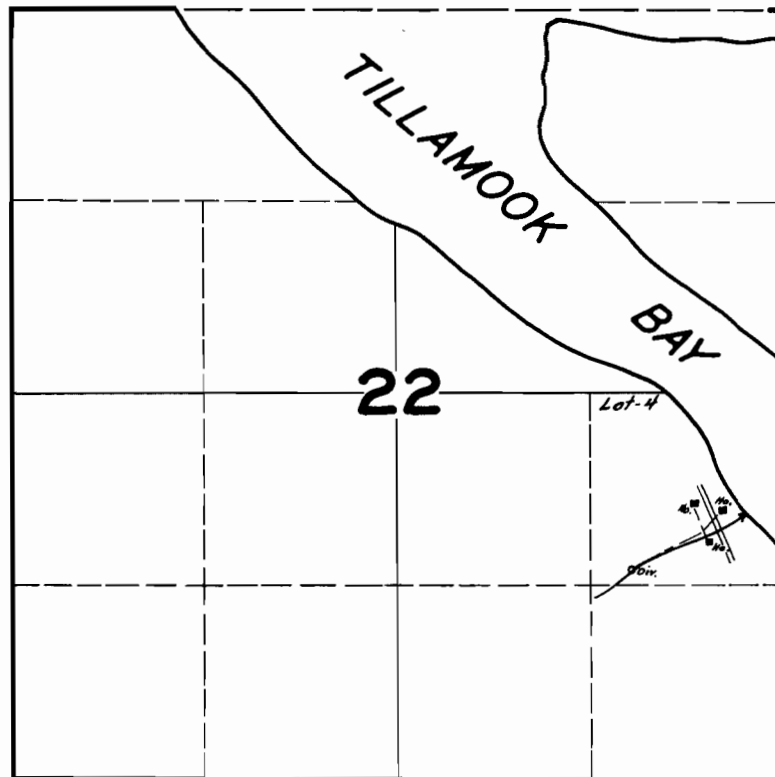

FINAL PROOF SURVEY
UNDER

Application No. 19557 Permit No. 15140

IN NAME OF

FRED & MILLIE BIGGS

Surveyed JUNE 19 1945, by

[Handwritten signature]

SURVEYORS CERTIFICATE
 I, W.E. Anderson of Tillamook OREGON
 do hereby certify that this map was made
 from notes taken during an actual survey
 made by me in April 1939, and that it
 correctly represents the works herein shown.

W.E. Anderson



Memaloose point
 Tillamook County

TILLAMOOK BAY

Lot 4

Fred & Millie
 Biggs

MEMALOOSE CK.
 800' 3/4

on point of division
 150' north & 875' West
 of the N.E. corner of the
 SE 1/4 of SE 1/4 Sec 22

Memaloose Creek

Tillamook Bay Ocean County Road

19557 ac
 1-60

RECEIVED
 NOV 13 1941
 STATE ENGINEER
 SALEM, OREGON

Lot 11
 A.G. Beals

22 23
 27 26

Application No 19557
 Permit No. 15140

WATER-RIGHT
 FRED & MILLIE BIGGS.
 LOCATED IN SECTION 22
 T. 1 S. R. 10 W. W. 1 TILLAMOOK
 OREGON Scale 1" = 400'