


# T.25S. R.5W.W.M.

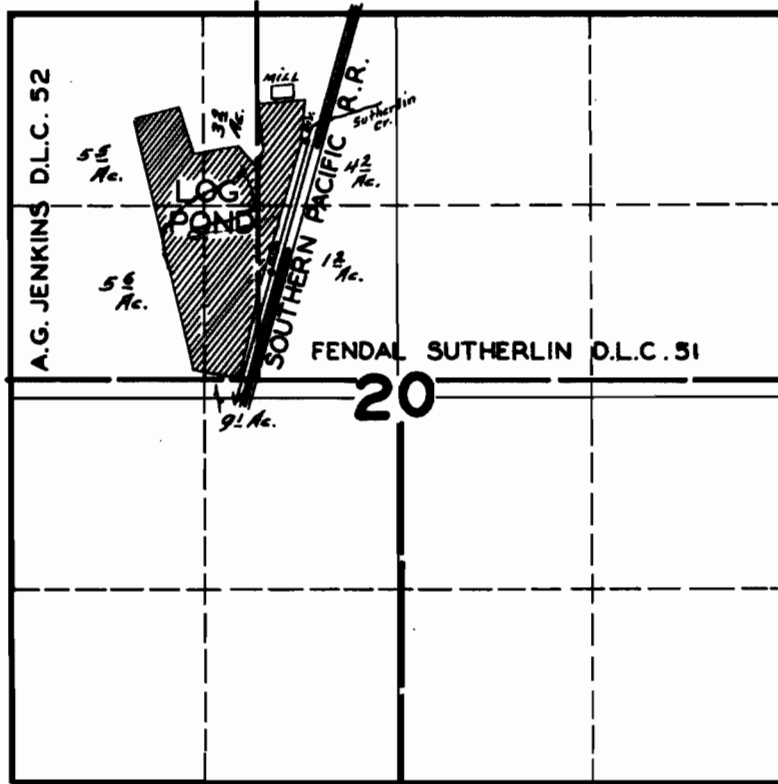

## FINAL PROOF SURVEY UNDER

Application No. 19590 Permit No. 15178

IN NAME OF

SPRINGFIELD PLYWOOD CORPORATION

Surveyed JULY 10, 1945, by *James S. Russell*