


# T.14S. R.9W.W.M.

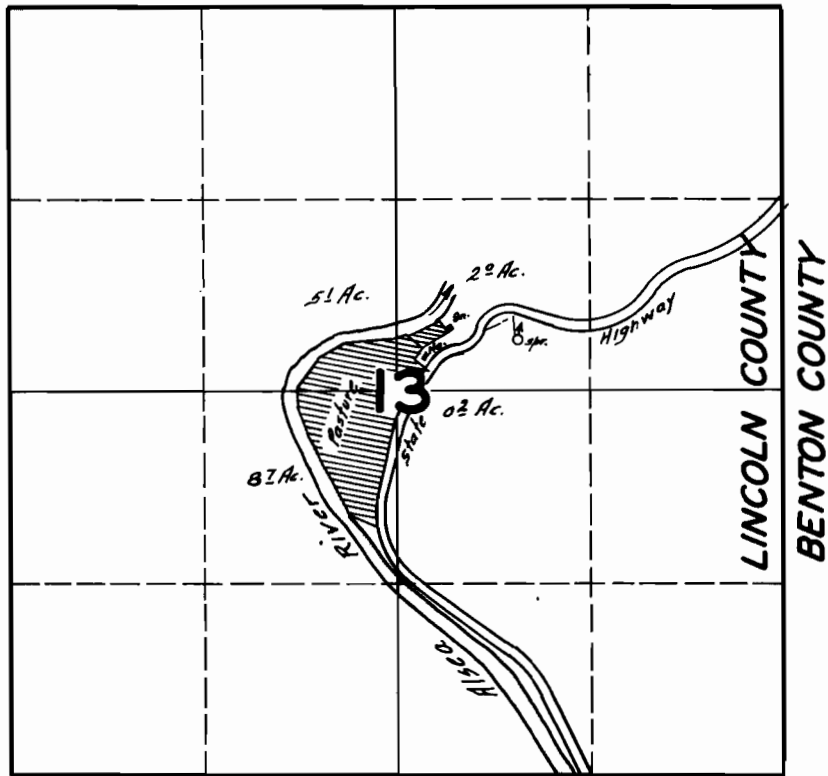

## FINAL PROOF SURVEY UNDER

Application No. 19634 Permit No. 15208

IN NAME OF

J.H. CALLAHAN

Surveyed AUG. 9, 1945, by [Signature]