


Willow Creek Adjudication

Part 35.26  
25.26

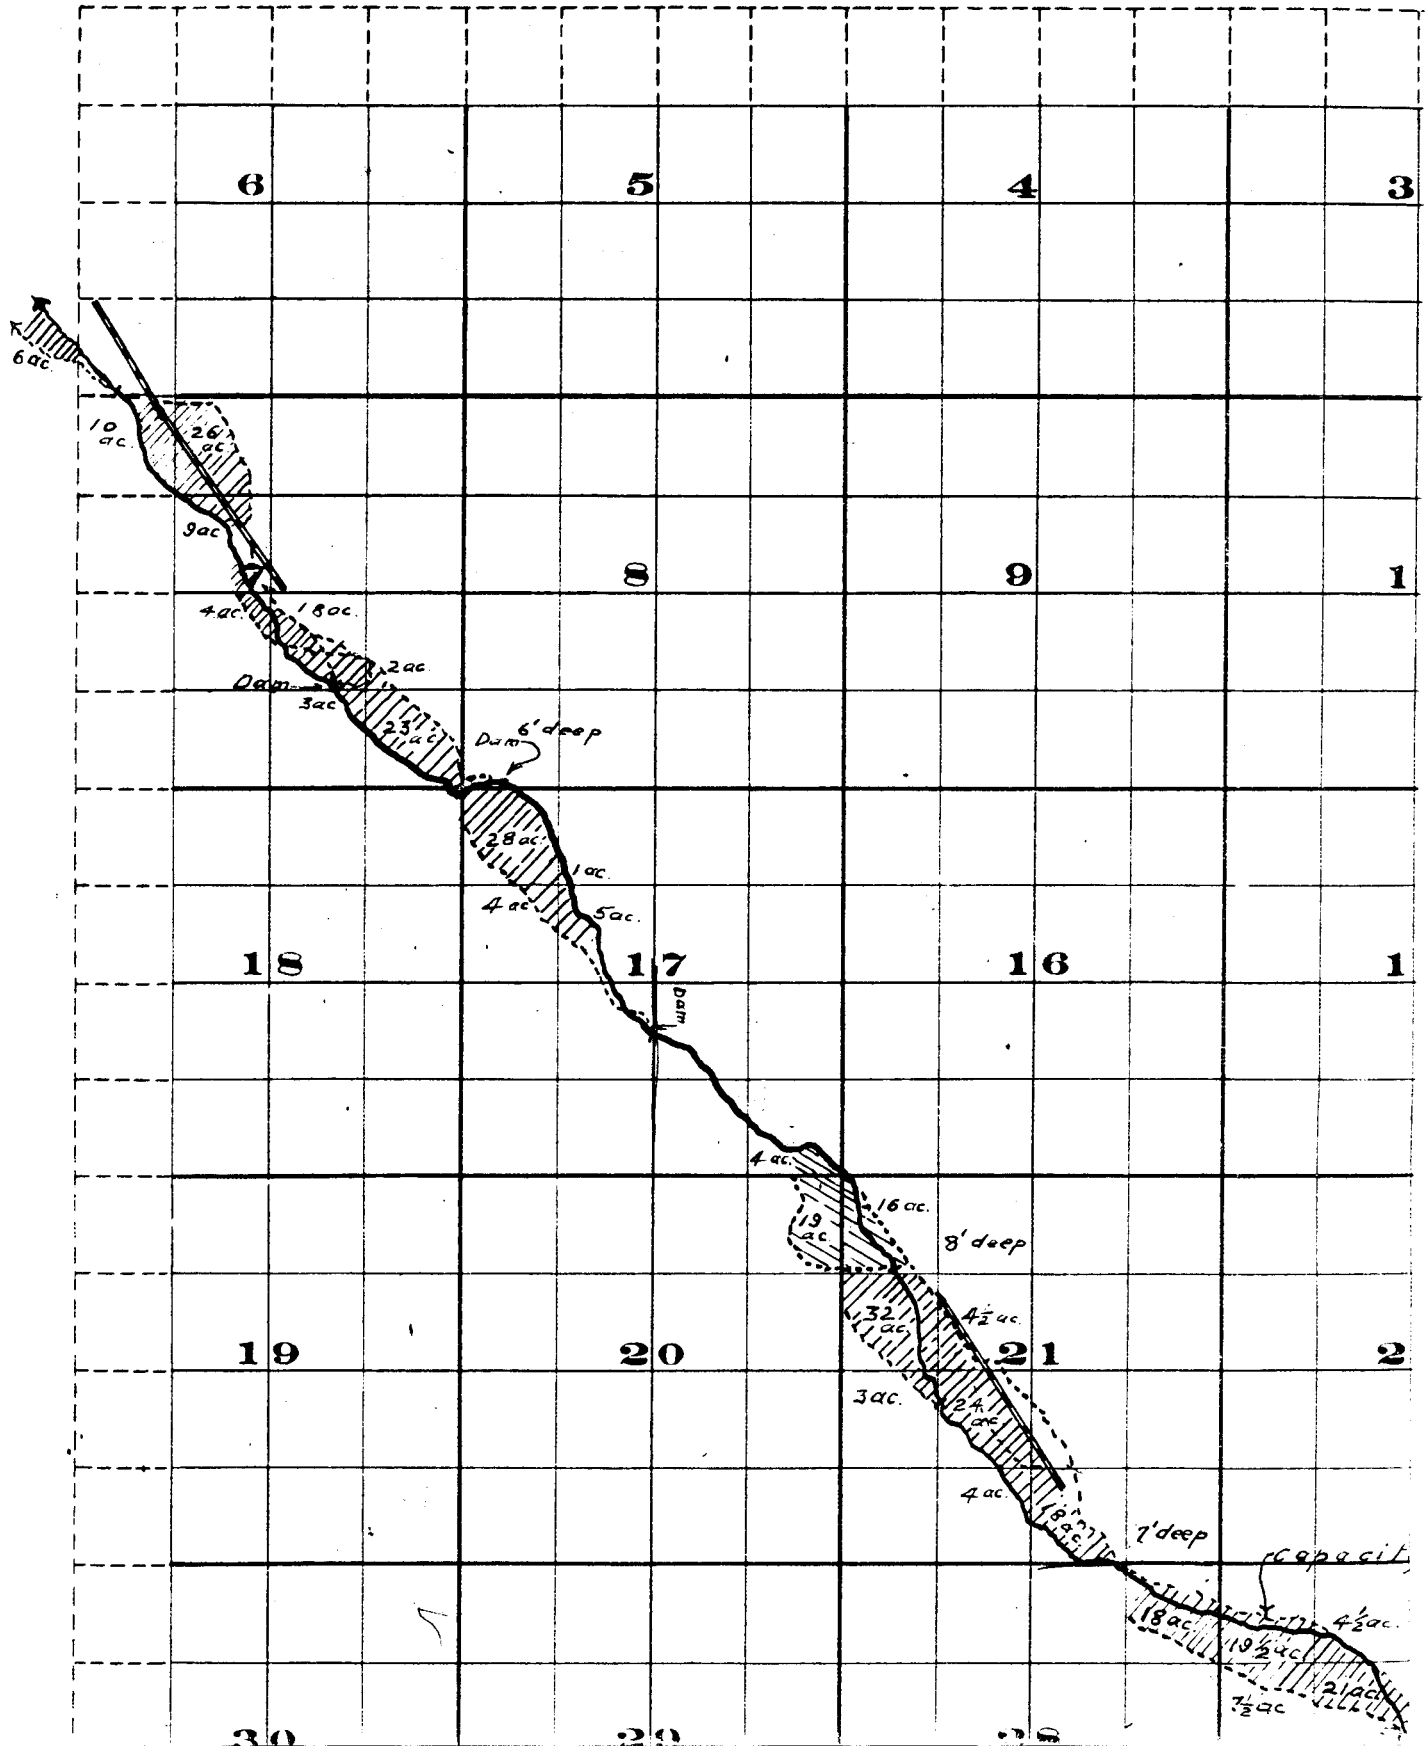

# Township 2 S.



# Range 26 E. W. M.

