


T. 7 S. R. 5 W. W. M.

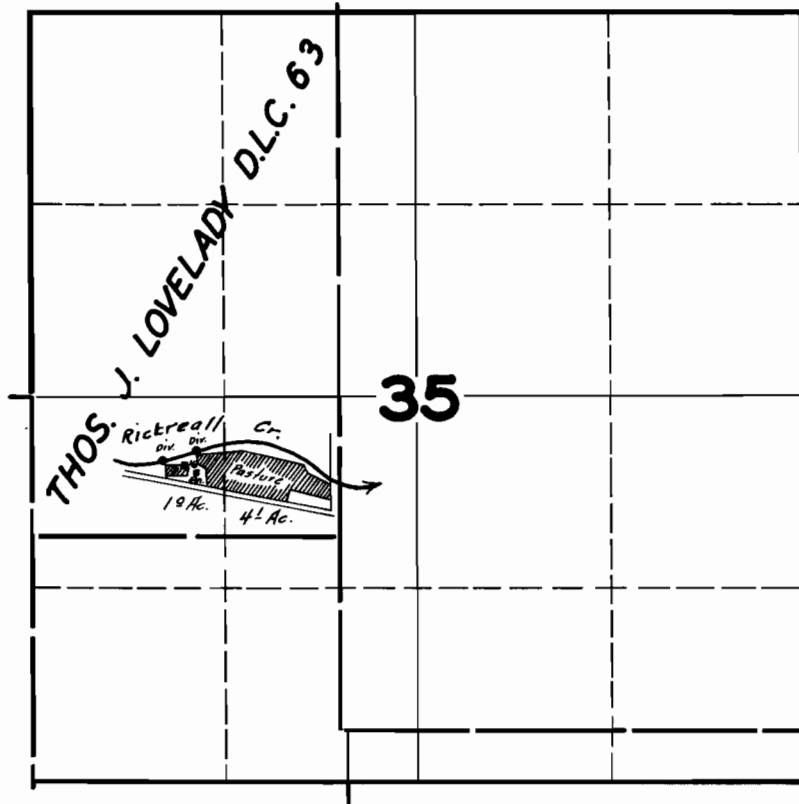

FINAL PROOF SURVEY UNDER

Application No. 19676 Permit No. 15256

IN NAME OF
CARL B. KREFT

Surveyed MAR. 4 1946, by [Signature]