


# T.29S. R.5W.W.M.

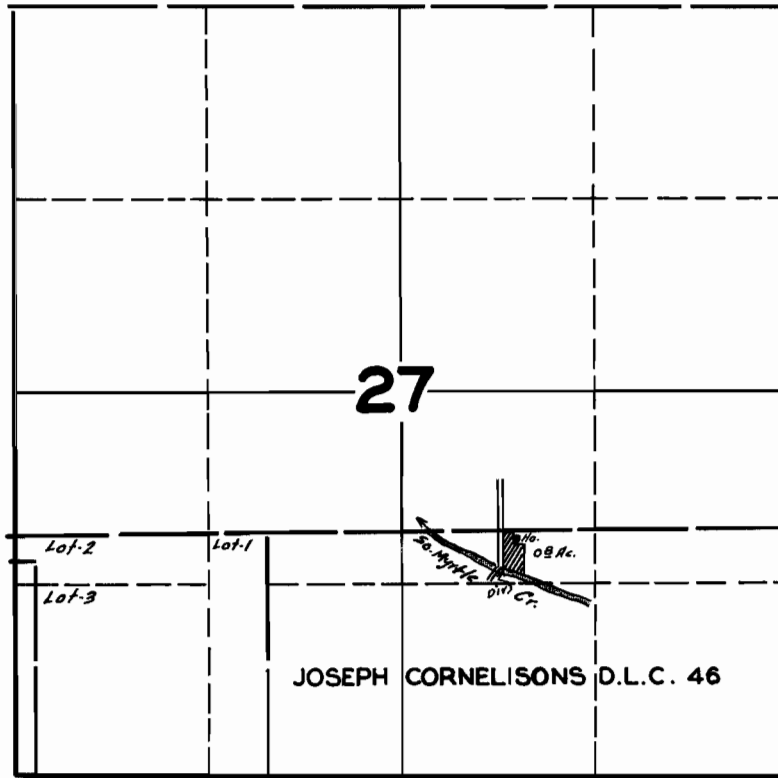

## FINAL PROOF SURVEY UNDER

Application No. 19931 Permit No. 15505

IN NAME OF  
W.C. BROWNSON

Surveyed JULY 12, 1945, by Frank Russell