


# T.2 S. R. I. E. W. M.

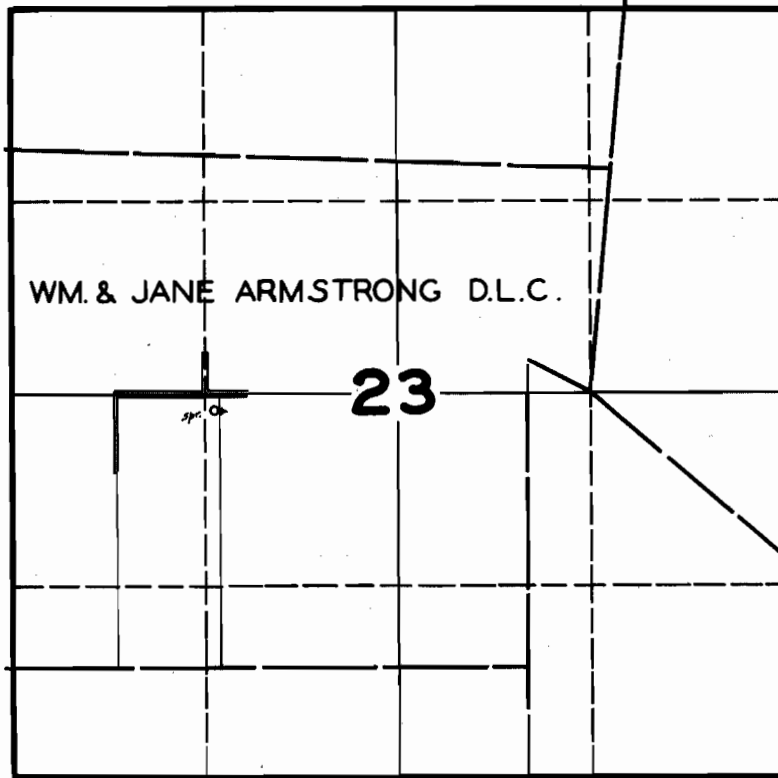

## FINAL PROOF SURVEY UNDER

Application No. 19933 Permit No. 15507

IN NAME OF

ERNEST ANNAS.

Surveyed JUNE 15 1945, by James H. Russell