


T.16S. R.2W.W.M.

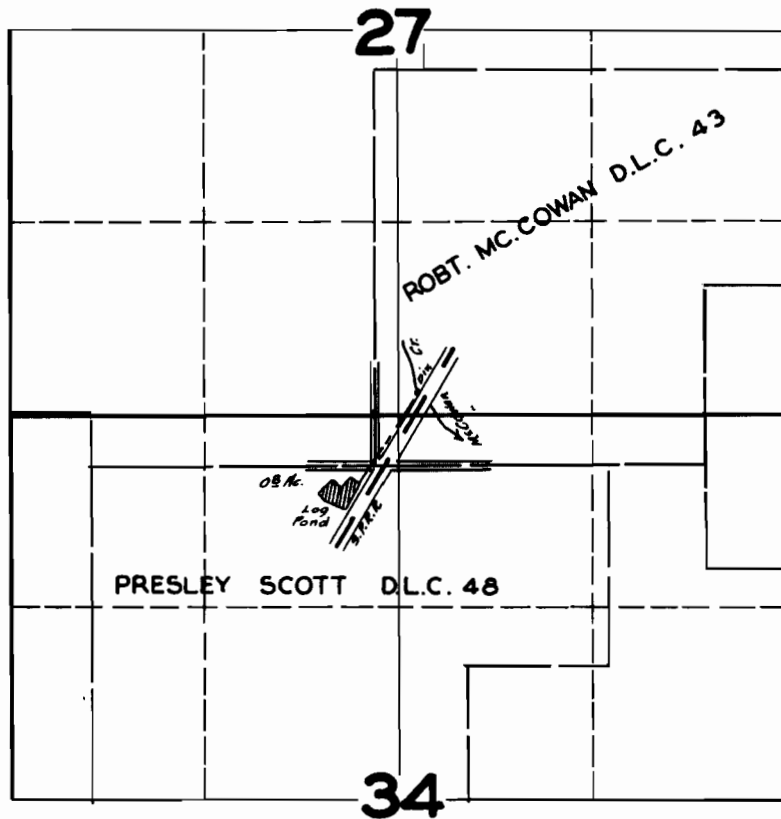

FINAL PROOF SURVEY UNDER

Application No. 19860 Permit No. 15520

IN NAME OF
SMITH & SON

Surveyed AUG. 2, 1945, by *J. E. Russell*