


T.3S. R.9W.W.M.

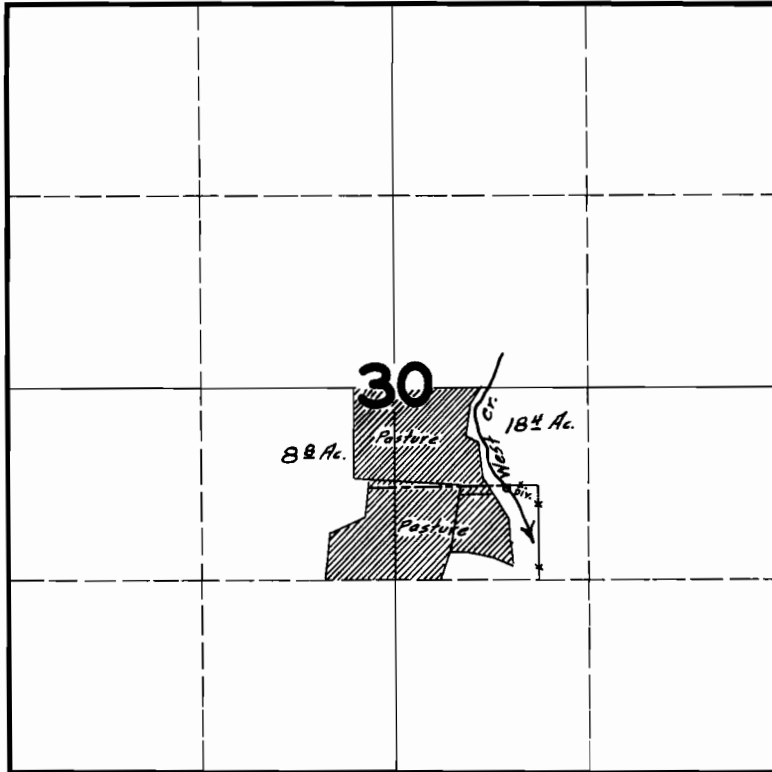

FINAL PROOF SURVEY
UNDER

Application No. 19961 Permit No. 15569

IN NAME OF
J. H. CALLAHAN

Surveyed JUNE 6 1945, by [Signature]