


T.41S. R.13W.W.M

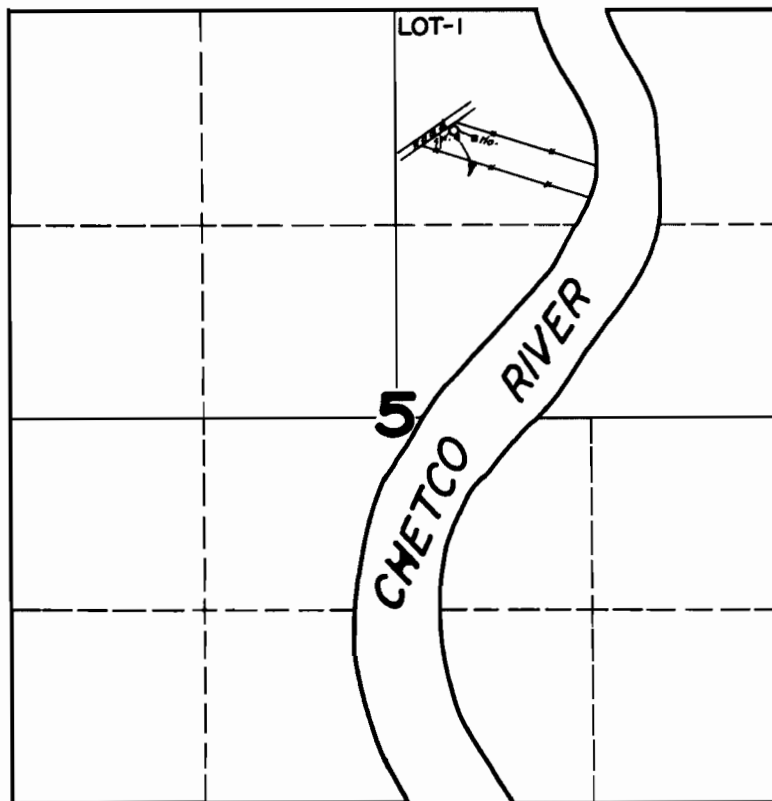

FINAL PROOF SURVEY UNDER

Application No. 20020 Permit No. 15591

IN NAME OF

WILLARD F. MILLER

Surveyed JULY 16, 1945, by *J. E. Hannell*