


T.17S. R.2W.W.M.

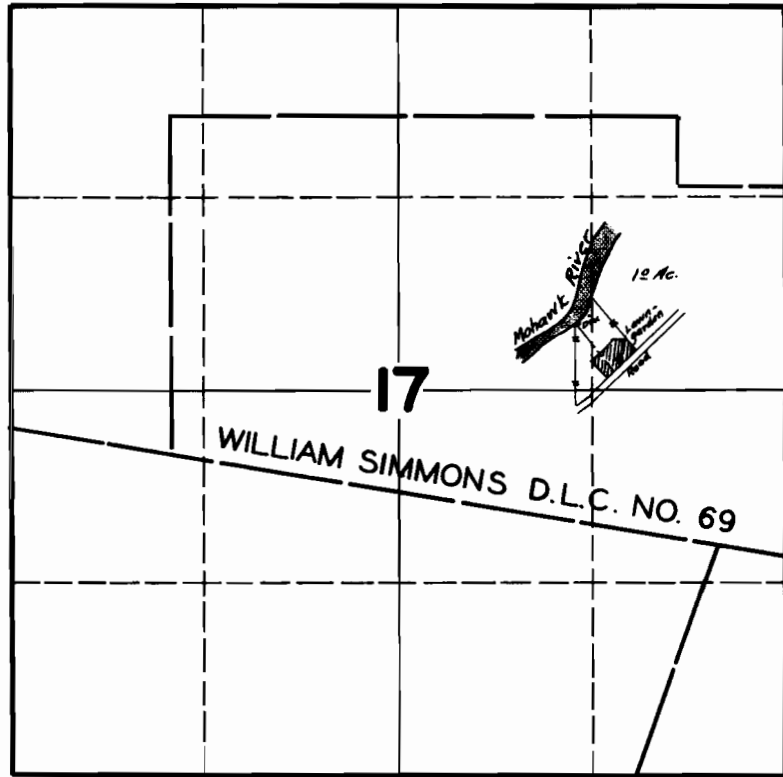

FINAL PROOF SURVEY
UNDER

Application No. 20024 Permit No. 15595

IN NAME OF
LOYAL HUGHSON OSTRANDER

Surveyed AUG. 2, 1945, by [Signature]