


T.29S.R.13W.W.M.

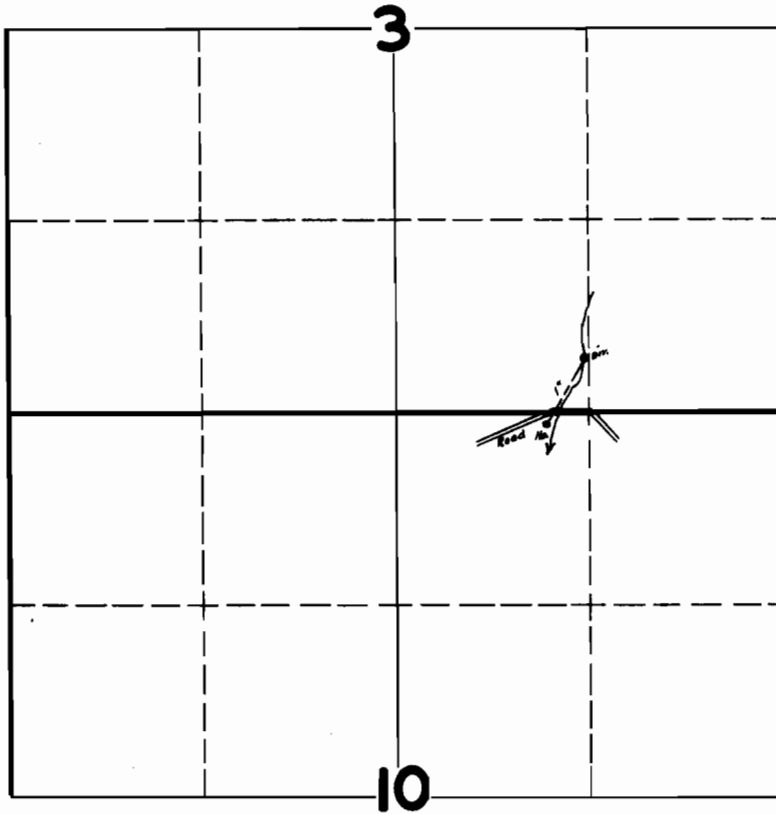

FINAL PROOF SURVEY
UNDER

Application No. 20073 Permit No. 15641

IN NAME OF

H.E. WATKINS

Surveyed JULY 19 1945 by Frank B. Sumrell